

WALTHALL

C 2022

10-14-77

MISSISSIPPI BOARD OF WATER COMMISSIONERS 416 North State Street Jackson, Mississippi 39201

132

WATER WELL DRILLERS LOG

16-14 date well completed

19 77 Filgual well Luvie firm name

Walthall county well located


LANDOWNER:	description of fomations encountered	from	to
Xcell Conerly P.O. Lytle, Tenn. Miss. (mailing address)			
<b>WELL LOCATION:</b> sec. 20 T 3 N R 10 E S                  W 8 miles NW of Lytle (distance) (direction) (nearest town)			
<b>WELL PURPOSE:</b> (home, irrigation, municipal, industrial)			
<b>WELL COMPLETION DATA:</b> (1) diameter (inches) 4 (2) total depth (feet) 146 (3) static water level (feet) 95 below top of ground. (4) casing PVC, 138, (material) (depth) 4 (size) if telescope see back. (5) screen 8, 138 (length) (depth to top) 4 (size) PVC (material) (6) pump 1/2, 10 (HP) (yield gpm) Elex (type power) (7) electric log No (yes or no) (organization running log) (8) how well bottom plugged sand filter			
<b>DRILLERS REMARKS:</b>			

RECEIVED OCT 31 1977

MISS. BD. OF WATER COMMISSIONERS

If well telescopes please sketch and show depths.

GROUND LEVEL

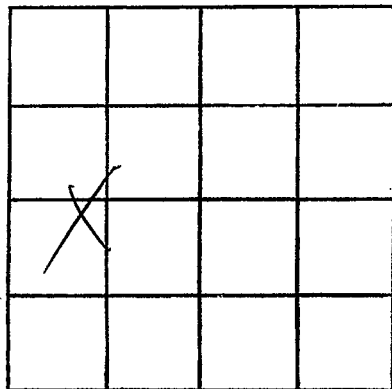

SECTION 20

Please indicate well location X.

ADDITIONAL INFORMATION

If more than one screen,  
show locations of each on sketch.