

WALTHALL

MISSISSIPPI  
BOARD OF WATER COMMISSIONERS  
416 North State Street  
Jackson, Mississippi 39201

WATER WELL DRILLERS LOG

March 5 1978 News Miller Walthall  
date well completed firm name county well located

LANDOWNER:

Michir Montgomery  
Rt 3 Tiptonville  
(mailing address)

description of formations encountered

from to

Red Clay 0 27  
Red sand 27 85  
gravelly sand 85 98  
clay 98 135  
gravelly sand 135 150

WELL LOCATION:

sec 12 T 3 N R 70 E  
1 miles east of Duran  
(distance) (direction) (nearest town)

WELL PURPOSE:

home  
(home, irrigation, municipal, industrial)

WELL COMPLETION DATA:

- (1) diameter (inches) 4"
- (2) total depth (feet) 150
- (3) static water level (feet) 90 below top of ground.
- (4) casing plastic bottom (material) (depth)
- (5) screen 5" (length) 145" (depth to top)  
4" (size) plastic (material)
- (6) pump 1/2 HP (HP) 10 (yield gpm)  
1/2 (type power)
- (7) electric log no (yes or no)

(organization running log)

(8) how well bottom plugged

wooden plug

DRILLERS REMARKS:

2" well vent bad


RECEIVED

MAY 11 1978

MISS. BD. OF WATER COMM

If well telescopes please sketch and show depths.

GROUND LEVEL

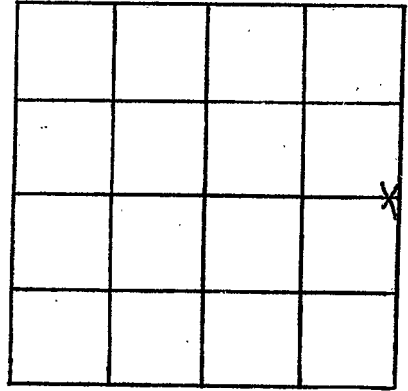

SECTION 12

Please indicate well location X.

ADDITIONAL INFORMATION

If more than one screen,  
show locations of each on sketch.