

WALTHALL
 C 20035
 5/9/78

MISSISSIPPI
 BOARD OF WATER COMMISSIONERS
 416 North State Street
 Jackson, Mississippi 39201

WATER WELL DRILLERS LOG

5-9 1978 Fitzgerald Well Serv Walthall
 date well completed firm name county well located

LANDOWNER: C. D. Byrd
R. B. Fitzhugh, Mrs
 (mailing address)

description of formations encountered

	from	to
<u>Real clay</u>	<u>0</u>	<u>20</u>
<u>Real sand & gravel</u>	<u>20</u>	<u>115</u>
<u>Course sand & gravel</u>	<u>115</u>	<u>126</u>

WELL LOCATION:
 sec. 32 T. 3 N R. 10 E
6 miles NW of Fitzhugh
 (distance) (direction) (nearest town)

WELL PURPOSE: Home
 (home, irrigation, municipal, industrial)

WELL COMPLETION DATA:

(1) diameter (inches) 4

(2) total depth (feet) 126

(3) static water level (feet) 101 below above top of ground.

(4) casing PVC 118
 (material) (depth)
4 If telescope see back:
 (size)

(5) screen 8 118
 (length) (depth to top)
4 PVC
 (size) (material)

(6) pump 1/2 8
 (HP) (yield gpm)
Ebe
 (type power)

(7) electric log no
 (yes or no)
 (organization running log)

(8) how well bottom plugged Sand shell


DRILLERS REMARKS:

RECEIVED
 JUN 23 1978

MISS. BD. OF WATER COMM

If well telescopes please sketch and show depths.

GROUND LEVEL

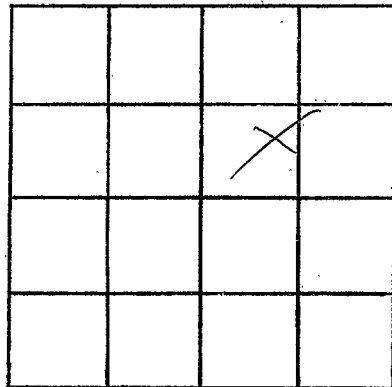

SECTION 32

Please indicate well location X.

ADDITIONAL INFORMATION

If more than one screen,
show locations of each on sketch.