

WALTHALL

G. D. ...

6-20-78

MISSISSIPPI
BOARD OF WATER COMMISSIONERS
416 North State Street
Jackson, Mississippi 39201

WATER WELL DRILLERS LOG

6-20

1978

Fitzgerald Well Serv
firm name

Walthall
county well located

LANDOWNER:

Leo Alexander

R.R. Tylston, 7725
(mailing address)

description of formations encountered

from

to

<i>Red clay</i>	<i>0</i>	<i>20</i>
<i>Red sand</i>	<i>20</i>	<i>80</i>
<i>Red gravel</i>	<i>80</i>	<i>115</i>
<i>Coarse sand & gravel</i>	<i>115</i>	<i>126</i>

WELL LOCATION:

sec. 1 T. 3 N. R. 10 E
S W


7 miles N of Tylston
(distance) (direction) (nearest town)

WELL PURPOSE:

Home
(home, irrigation, municipal, industrial)

WELL COMPLETION DATA:

- (1) diameter (inches) 4
- (2) total depth (feet) 126
- (3) static water level (feet) 70 below above top of ground.
- (4) casing PVC 118
(material) (depth)
4 if telescope see back.
(size)
- (5) screen 8 118
(length) (depth to top)
4 PVC
(size) (material)
- (6) pump 1/2 10
(HP) (yield gpm)
electric
(type power)
- (7) electric log no
(yes or no)
(organization running log)
- (8) how well bottom plugged Sand block

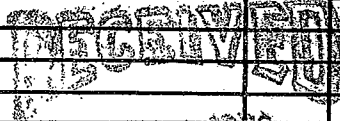


AUG 14 1978

DRILLERS REMARKS:

MISS. BD. OF WATER COMMISSIONERS

If well telescopes please sketch and show depths.

GROUND LEVEL

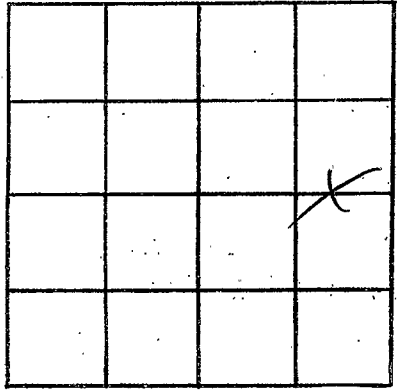

SECTION 1

Please indicate well location X.

ADDITIONAL INFORMATION

If more than one screen, show locations of each on sketch.