

WALTHALL

C 2057

6-24-78

MISSISSIPPI BOARD OF WATER COMMISSIONERS 416 North State Street Jackson, Mississippi 39201

WATER WELL DRILLERS LOG

Jan 24 1978 date well completed

Rever Well Co firm name

Walthall county well located

LANDOWNER:

Roxton Crawford Rt 2 Tipton (mailing address)

description of formations encountered

from to

Sandy Clay 0 19 Sand & Gravel 19 90 White Chalk 90 135 Sand 135 142 blue Chalk 142 180 Coarse Sand 180 225

WELL LOCATION:

sec. 31 T. 3 N R. 10 E @ WNW of Tipton (distance) (direction) (nearest town)

WELL PURPOSE: house (home, irrigation, municipal, industrial)

WELL COMPLETION DATA:

- (1) diameter (inches) 4" (2) total depth (feet) 225 (3) static water level (feet) 160 below top of ground. (4) casing plastic bottom (material) (depth) (size) if telescope see back. (5) screen 10' 215 (length) (depth to top) 4" plastic (size) (material) (6) pump 3/4 HP 10 (type power) (yield gpm) (7) electric log no (yes or no)

(organization running log)

(8) how well bottom plugged Washer Plug

DRILLERS REMARKS:


other well hit by lightning

RECEIVED ALL OCT 25 1978

MISS. BD. OF WATER COMMISSIONERS

If well telescopes please sketch and show depths.

GROUND LEVEL

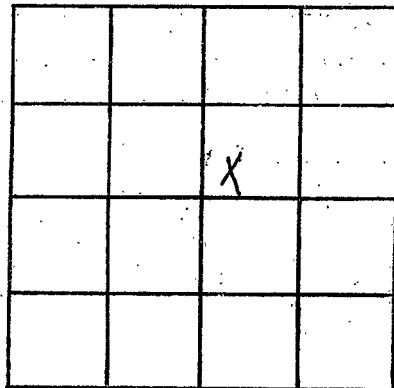

SECTION 31

Please indicate well location X.

ADDITIONAL INFORMATION

If more than one screen,
show locations of each on sketch.