

WALTHALL

C 2028

9-19-78

MISSISSIPPI BOARD OF WATER COMMISSIONERS 416 North State Street Jackson, Mississippi 39201

WATER WELL DRILLERS LOG

9-19 date well completed

19 78 firm name

Walthall county well located

LANDOWNER:

Charlie Holmes

Rob. Lytle (mailing address)

description of formations encountered

from to

Red Clay 0 20 Red granite 20 115 coarse sand & gravel 115 126

WELL LOCATION:


sec. 19 T 3 N R 10 E S W 7 2 miles W of Lytle (distance) (direction) (nearest town)

WELL PURPOSE: Home (home, irrigation, municipal, industrial)

WELL COMPLETION DATA:

- (1) diameter (inches) 4
(2) total depth (feet) 134
(3) static water level (feet) 106 below above top of ground.
(4) casing PVC, 126 (material) (depth)
(5) screen 8, 126 (length) (depth to top)
(6) pump 1/2, 10 (HP) (yield gpm)
(7) electric log no (yes or no)


DRILLERS REMARKS:

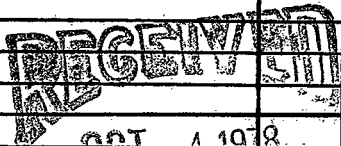

MISS. BD. OF WATER COMMISSIONERS

If well telescopes please sketch and show depths.

GROUND LEVEL

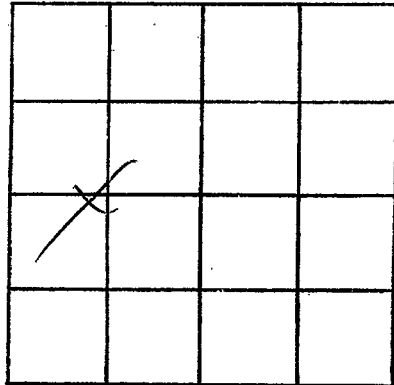

SECTION 19

Please indicate well location X.

ADDITIONAL INFORMATION

If more than one screen, show locations of each on sketch.