

WALTHALL

C

10-12-78

MISSISSIPPI BOARD OF WATER COMMISSIONERS  
416 North State Street  
Jackson, Mississippi 39201

WATER WELL DRILLERS LOG

10-12-78 date well completed  
Fitzgerald Sew firm name  
Walthall county well located

LANDOWNER:  
Ray Richmond  
R.R. Lybltown  
(mailing address)

description of formations encountered	from	to
Red Clay	0	20
Red Sand	20	60
Coarse Sand	60	80

WELL LOCATION:  
sec. 28 T 3 N R 10 E  
S W  
6 miles N of Lybltown  
(distance) (direction) (nearest town)

WELL PURPOSE: Home  
(home, irrigation, municipal, industrial)


- WELL COMPLETION DATA:
- (1) diameter (inches) 4
  - (2) total depth (feet) 80
  - (3) static water level (feet) 50 below above top of ground.
  - (4) casing PVC 72  
(material) (depth)  
4 (size) if telescope see back.
  - (5) screen 8 72  
(length) (depth to top)  
4 PVC  
(size) (material)
  - (6) pump 1/2 10  
(HP) (yield gpm)  
Elec  
(type power)
  - (7) electric log No  
(yes or no)  
(organization running log)
  - (8) how well bottom plugged Seal hole

DRILLERS REMARKS:

RECEIVED  
DEC - 7 1978

If well telescopes please sketch and show depths.

GROUND LEVEL

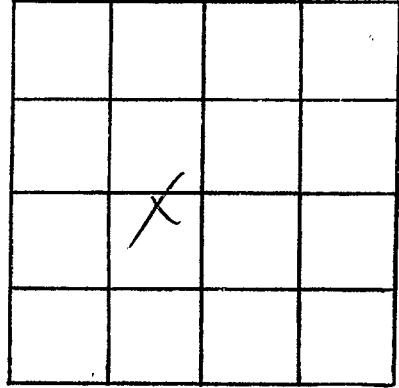

SECTION 28

Please indicate well location X.

ADDITIONAL INFORMATION

If more than one screen,  
show locations of each on sketch.