

WALTHALL
C 2030
8-24-78

MISSISSIPPI  
 BOARD OF WATER COMMISSIONERS  
 416 North State Street  
 Jackson, Mississippi 39201

WATER WELL DRILLERS LOG

Aug 24 1978 Reever Well for Walthall  
 date well completed firm name county well located

LANDOWNER:  
 Jessie Llocum  
 Rt 3 Tylertown  
 (mailing address)

description of formations encountered	from	to
Red Clay	0	23
Red & gravel	25	96
White Chalk	96	180
Coarse sand	180	203


WELL LOCATION:  
 sec 31 T 3 N R 10 E  
 6 miles W.N.W. of Tylertown  
 (distance) (direction) (nearest town)

WELL PURPOSE: home  
 (home, irrigation, municipal, industrial)

- WELL COMPLETION DATA:
- (1) diameter (inches) 4"
  - (2) total depth (feet) 203
  - (3) static water level (feet) 128 below top of ground.
  - (4) casing plastic bottom (material) (depth)
  - (5) screen 10' (length) 193' (depth to top)  
 4" (size) plastic (material)
  - (6) pump 1/2 hp (HP) 15 (yield gpm)  
 elect (type power)
  - (7) electric log no (yes or no)
- (organization running log)

(8) how well bottom plugged  
 W. P. P. P. P.

DRILLERS REMARKS:  
 [Signature]

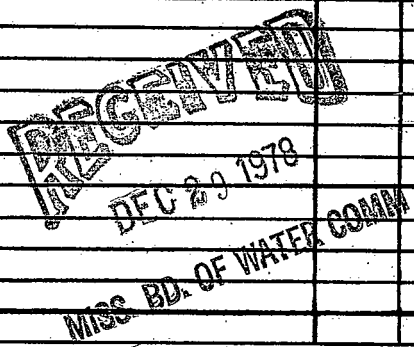

If well telescopes please sketch and show depths.

GROUND LEVEL

			X

SECTION 31

Please indicate well location X.

ADDITIONAL INFORMATION

If more than one screen, show locations of each on sketch.