

WALTHALL

C 2031

12-21-78

MISSISSIPPI
BOARD OF WATER COMMISSIONERS
416 North State Street
Jackson, Mississippi 39201

WATER WELL DRILLERS LOG

12-21-78
date well completed

1978 Fitzgerald Well Serv
firm name

Walthall
county well located

LANDOWNER:	description of formations encountered	from	to
Ray Blackwell R.R. Lytleton (mailing address)	Red clay Red sand gravel Coarse sand gravel	0 20 130	20 130 140
WELL LOCATION:			
sec. 28 T 3 N R 10 E S W 5 miles W of Lytleton (distance) (direction) (nearest town)			
WELL PURPOSE: Home (home, irrigation, municipal, industrial)			
WELL COMPLETION DATA:			
(1) diameter (inches) 4			
(2) total depth (feet) 140			
(3) static water level (feet) 100 below top of ground.			
(4) casing PUC, 132, (material) (depth)			
4 (size) if telescope see back.			
(5) screen 8, 132 (length) (depth to top)			
4 (size) PUC (material)			
(6) pump 1/2, 10 (HP) (yield gpm)			
Electric (type power)			
(7) electric log No (yes or no)			
(organization running log)			
(8) how well bottom plugged Sand fill			
DRILLERS REMARKS:			


RECEIVED

JAN 26 1978

MISS. BD. OF WATER COMM

If well telescopes please sketch and show depths.

GROUND LEVEL

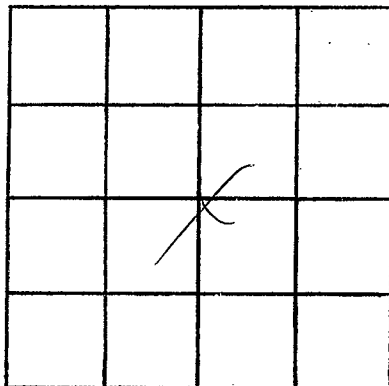

SECTION 28

Please indicate well location X.

ADDITIONAL INFORMATION

If more than one screen,
show locations of each on sketch.