

WALTHALL
C 2032
3-31-79

MISSISSIPPI
BOARD OF WATER COMMISSIONERS
416 North State Street
Jackson, Mississippi 39201

WATER WELL DRILLERS LOG

3-31 1979 Fitzgerald Well Serv Walthall
date well completed firm name county well located

LANDOWNER:
Rosemary Smith
R.R. Feltner
(mailing address)
WELL LOCATION: 10
sec. 7 T. 3 N. R. 10 E.
2 miles W of Senon
(distance) (direction) (nearest town)

WELL PURPOSE: Home
(home, irrigation, municipal, industrial)

WELL COMPLETION DATA:
(1) diameter (inches) 4
(2) total depth (feet) 179
(3) static water level (feet) 100 below above top of ground.
(4) casing PVC, 171,
(material) (depth)
4 If telescope see back.
(size)
(5) screen 8, 171
(length) (depth to top)
4, PVC
(size) (material)
(6) pump 1/2, 10
(HP) (yield gpm)
Electric
(type power)
(7) electric log No
(yes or no)
(organization running log)
(8) how well bottom plugged Sand filter

| description of formations encountered | from | to |
|---------------------------------------|------|-----|
| Red Clay | 0 | 20 |
| Red Soil | 20 | 80 |
| White Chalk | 80 | 140 |
| Fine Sand | 140 | 170 |
| Coarse Sand & Gravel | 170 | 179 |

DRILLERS REMARKS:


MAY 30 1979

RECEIVED

Miss. Board of Water Comm.

If well telescopes please sketch and show depths.

GROUND LEVEL

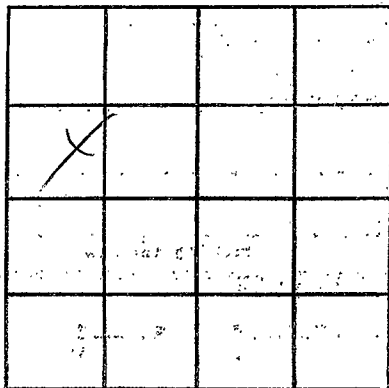

SECTION 7

Please indicate well location X

ADDITIONAL INFORMATION

If more than one screen, show locations of each on sketch.