

WALTHALL

C 2033

2/16/79

MISSISSIPPI BOARD OF WATER COMMISSIONERS

416 North State Street
Jackson, Mississippi 39201

WATER WELL DRILLERS LOG

Feb 16 1979
date well completed

Reynolds Miller
firm name

Walthall
county well located

LANDOWNER:

John Martin
At 3 Tylitown
(mailing address)

description of formations encountered

from

to

| | | |
|-------------------|-----|-----|
| Red sandy clay | 0 | 18 |
| Red sand | 18 | 76 |
| gravel | 76 | 82 |
| shales | 82 | 103 |
| fine grained sand | 103 | 115 |

WELL LOCATION:

sec. 7 T. 3 N R. 10 E
9 1/2 miles N-NW of Tylitown
(distance) (direction) (nearest town)

WELL PURPOSE: Domestic
(home, irrigation, municipal, industrial)

WELL COMPLETION DATA:

- (1) diameter (inches) 4"
- (2) total depth (feet) 115'
- (3) static water level (feet) 80' below top of ground.
- (4) casing plastic, (material) (depth) (bottom)
- (size) If telescope see back.
- (5) screen 5' (length) 110' (depth to top)
- 4" (size) plastic (material)
- (6) pump 1/2 HP (HP) 100 (yield gpm)
- shot (type power)
- (7) electric log no (yes or no)
- (organization running log)

(8) how well bottom plugged
wood plug

DRILLERS REMARKS:


Miss. Board of Water Comm.

JUN 18 1979

RECEIVED

If well telescopes please sketch and show depths.

GROUND LEVEL

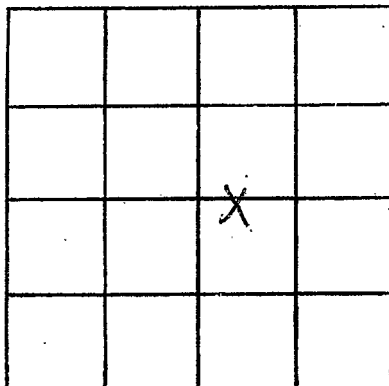

SECTION 7

Please indicate well location X.

ADDITIONAL INFORMATION

If more than one screen,
show locations of each on sketch.