

WALTHALL

C 1034

7/30/79

MISSISSIPPI BOARD OF WATER COMMISSIONERS
416 North State Street
Jackson, Mississippi 39201

WATER WELL DRILLERS LOG

7-30 1979
date well completed

Fitzgerald Well Serv
firm name

Walthall
county well located

LANDOWNER:

Leon Magee

R.R. Tylertown
(mailing address)

WELL LOCATION:

sec. 32 T 3 N R 10 E
6 miles W of Tylertown
(distance) (direction) (nearest town)

WELL PURPOSE: Home
(home, irrigation, municipal, industrial)

WELL COMPLETION DATA:

- (1) diameter (inches) 4 ~~1 1/2~~
- (2) total depth (feet) 192
- (3) static water level (feet) 112 below top of ground
- (4) casing PVC 184
(material) (depth)
4 if telescope see back.
(size)
- (5) screen 8 184
(length) (depth to top)
4 PVC
(size) (material)
- (6) pump 1/2 10
(HP) (yield gpm)
alt
(type power)
- (7) electric log
(yes or no)
(organization running log)
- (8) how well bottom plugged Seal bit

description of formations encountered

from to

Red clay	0	20
Red sand	20	126
White & Blue clark	126	180
Coarse sand gravel	180	192

DRILLERS REMARKS:


Miss. Board of Water Comm.

AUG 3 1979

RECEIVED

If well telescopes please sketch and show depths.

GROUND LEVEL

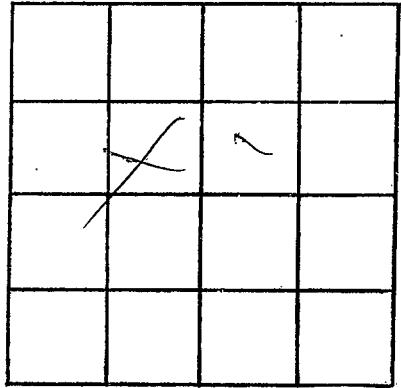

SECTION 32

Please indicate well location X.

ADDITIONAL INFORMATION

If more than one screen, show locations of each on sketch.