

Walthall  
C  
2035  
8-23-79

MISSISSIPPI  
 BOARD OF WATER COMMISSIONERS  
 416 North State Street  
 Jackson, Mississippi 39201

WATER WELL DRILLERS LOG

8-23 1979 Fitzgerald Well Service Walthall  
 date well completed firm name county well located

LANDOWNER:	description of formations encountered	from	to
<u>Winston Carter Jr.</u> <u>P.R. Tylston</u> (mailing address)			
	<u>Red Clay</u>	<u>0</u>	<u>20</u>
	<u>Red Sand</u>	<u>20</u>	<u>140</u>
	<u>Coarse sand &amp; gravel</u>	<u>140</u>	<u>152</u>
WELL LOCATION:			
sec. <u>33</u> T <u>3</u> N R <u>10</u> E S W			
<u>6</u> miles <u>N</u> of <u>Tylston</u> (distance) (direction) (nearest town)			
WELL PURPOSE: <u>Home</u> (home, irrigation, municipal, industrial)			
WELL COMPLETION DATA:			
(1) diameter (inches) <u>4</u>			
(2) total depth (feet) <u>152</u>			
(3) static water level (feet) <u>95</u> below top of ground. above			
(4) casing <u>PVC</u> <u>144</u> (material) (depth)			
<u>4</u> if telescope see back. (size)			
(5) screen <u>8</u> <u>144</u> (length) (depth to top)			
<u>4</u> <u>PVC</u> (size) (material)			
(6) pump <u>1/2</u> <u>10</u> (HP) (yield gpm)			
<u>elm</u> (type power)			
(7) electric log <u>No</u> (yes or no)			
(organization running log)			
(8) how well bottom plugged <u>hard shell</u>			

Miss. Board of Water Comm.


SEP 12 1979

RECEIVED

DRILLERS REMARKS:

If well telescopes please sketch and show depths.

GROUND LEVEL

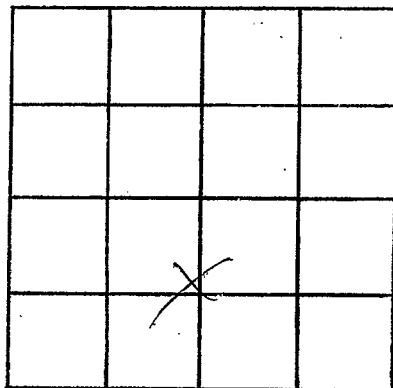

SECTION 35

Please indicate well location X.

ADDITIONAL INFORMATION

If more than one screen,  
show locations of each on sketch.