

MISSISSIPPI
 BOARD OF WATER COMMISSIONERS
 416 North State Street
 Jackson, Mississippi 39201

WATER WELL DRILLERS LOG

Walthall
C
2030
6-7-79
June 7 1979
 date well completed

Peewee Miller Walthall
 firm name county well located

LANDOWNER:
Elton Foil
Rt 3 Tylertown
 (mailing address)

| description of formations encountered | from | to |
|---------------------------------------|-----------|-----------|
| <u>clay</u> | <u>0</u> | <u>12</u> |
| <u>white chert sand</u> | <u>12</u> | <u>35</u> |
| <u>sand + gravel</u> | <u>35</u> | <u>50</u> |
| <u>Chalk</u> | <u>50</u> | <u>55</u> |
| <u>Coarse sand</u> | <u>55</u> | <u>71</u> |

WELL LOCATION:
 sec. 4 T. 3 N R. 10 E
10 miles ^S north of Tylertown
 (distance) (direction) (nearest town)

WELL PURPOSE: home
 (home, irrigation, municipal, industrial)

WELL COMPLETION DATA:
 (1) diameter (inches) 4"
 (2) total depth (feet) 71
 (3) static water level (feet) 38' below top of ground.
 (4) casing plastic bottom
 (material) (depth)
 _____ if telescope see back.
 (size)
 (5) screen 5' 66'
 (length) (depth to top)
4" plastic
 (size) (material)
 (6) pump by others
 (HP) (yield gpm)
elect
 (type power)
 (7) electric log no
 (yes or no)

 (organization running log)

(8) how well bottom plugged wooden plug
 DRILLERS REMARKS:


DEPT. OF NATURAL RESOURCES
 BUREAU OF LAND & WATER RESOURCES

NOV 19 1979

RECEIVED

If well telescopes please sketch and show depths.

GROUND LEVEL

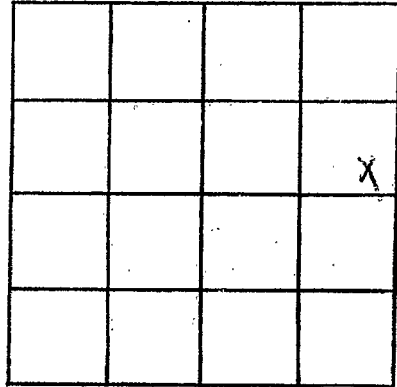

SECTION 4

Please indicate well location X.

ADDITIONAL INFORMATION

A series of horizontal lines for writing additional information.

If more than one screen, show locations of each on sketch.