

MISSISSIPPI DEPARTMENT OF NATURAL RESOURCES

Bureau of Land and Water Resources

Southport Mall

P.O. Box 10631

Jackson, Mississippi 39209

WATER WELL DRILLERS LOG

WALTHALL
C 2037
10-25-79

Oct 25 19 79 Reynolds Well Co Walthall
 date well completed firm name county well located

LANDOWNER:
Wayne Planché
Rt. 1 Gyltoman
 (mailing address)

description of formations encountered	from	to
<u>sandy clay</u>	<u>0</u>	<u>22</u>
<u>sand</u>	<u>22</u>	<u>40</u>
<u>clay</u>	<u>40</u>	<u>70</u>
<u>loam</u>	<u>70</u>	<u>95</u>
<u>fine gravel & sand</u>	<u>95</u>	<u>109</u>

WELL LOCATION:
 sec. 11 T. 3 N R. 10 E
8 miles north of Gyltoman
 (distance) (direction) (nearest town)

WELL PURPOSE: home
 (home, irrigation, municipal, industrial)

- WELL COMPLETION DATA:
- (1) diameter (inches) 4"
 - (2) total depth (feet) 109
 - (3) static water level (feet) 65' below top of ground.
 - (4) casing plastic bottom
 (material) (depth)
 - (size) if telescope see back.
 - (5) screen 5" 104'
 (length) (depth to top)
 - 4" plastic
 (size) (material)
 - (6) pump weather
 (HP) (yield gpm)
 - elect
 (type power)
 - (7) electric log no
 (yes or no)
 - (organization running log)

(8) how well bottom plugged
water plug

DRILLERS REMARKS:


DEPT. OF NATURAL RESOURCES
 BUREAU OF LAND & WATER RESOURCES

OCT - 9 1980

RECEIVED

If well telescopes please sketch and show depths.

GROUND LEVEL

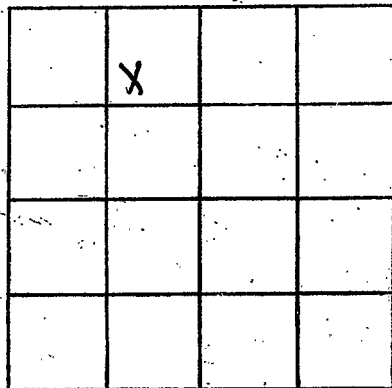

SECTION 11

Please indicate well location X.

ADDITIONAL INFORMATION

If more than one screen,
show locations of each on sketch.