

WALTHALL

C 2538

12-21-79

MISSISSIPPI BOARD OF WATER COMMISSIONERS
416 North State Street
Jackson, Mississippi 39201

WATER WELL DRILLERS LOG

12-21 1979
date well completed

Fitzpatrick Inc
firm name

Walthall
county well located

LANDOWNER:

Allie Bell Craft

R.R. Tuleton

(mailing address)

description of formations encountered

from to

Red clay

0 20

Red sand & gravel

20 140

Coarse sand & gravel

140 158

WELL LOCATION:

sec. 18 T. 3 N. R. 10 E. S. 5 W.

8 miles (distance) N.W. of Tuleton (direction) (nearest town)

WELL PURPOSE:

Home (home, irrigation, municipal, industrial)

WELL COMPLETION DATA:

- (1) diameter (inches) 4
- (2) total depth (feet) 158
- (3) static water level (feet) 90 below top of ground.
- (4) casing PVC, 150 (material), (depth), 4 (size) if telescope see back.
- (5) screen 8, 150 (length), (depth to top), 4 (size), PVC (material)
- (6) pump 1/2 (HP), 10 (yield gpm), Eli (type power)
- (7) electric log no (yes or no)
- (8) how well bottom plugged Sand & Sh.

DRILLERS REMARKS:


DEPT. OF NATURAL RESOURCES
BUREAU OF LAND & WATER RESOURCES

JAN 31 1980

RECEIVED

If well telescopes please sketch and show depths.

GROUND LEVEL

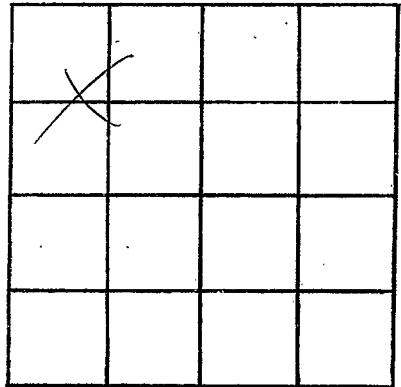

SECTION 18

Please indicate well location X.

ADDITIONAL INFORMATION

If more than one screen,
show locations of each on sketch.