

Walthall
 C 2035
 2-4-80

MISSISSIPPI
 BOARD OF WATER COMMISSIONERS
 416 North State Street
 Jackson, Mississippi 39201

WATER WELL DRILLERS LOG

2-4 1980 date well completed
 Fitcon Well Sec firm name
 Walthall county well located

LANDOWNER:	description of formations encountered	from	to
Billy Boyd			
RR1 Jones (mailing address)	Red sand	20	90
	Coarse sand & gravel	90	117
WELL LOCATION:			
sec. 12 T 3 N R 10 E S W			
3 miles W of Sabin (distance) (direction) (nearest town)			
WELL PURPOSE: Home (home, irrigation, municipal, industrial)			
WELL COMPLETION DATA:			
(1) diameter (inches) 4			
(2) total depth (feet) 117			
(3) static water level (feet) 75 below top of ground.			
(4) casing PVC, 109, (material) (depth) 4 (size) if telescope see back.			
(5) screen 8, 109 (length) (depth to top) 4, PVC (size) (material)			
(6) pump 1/2, 10 (HP) (yield gpm) Electric (type power)			
(7) electric log no (yes or no) (organization running log)			
(8) how well bottom plugged sand fill			

DEPT. OF NATURAL RESOURCES
 BUREAU OF LAND & WATER RESOURCES


MAR 25 1980

RECEIVED

DRILLERS REMARKS:

If well telescopes please sketch and show depths.

GROUND LEVEL

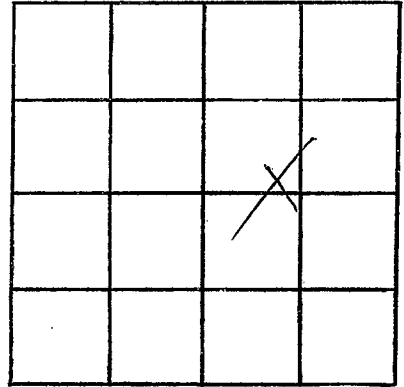

SECTION 12

Please indicate well location X.

ADDITIONAL INFORMATION

If more than one screen,
show locations of each on sketch.