

Walthall  
C 2040  
5-30-80

MISSISSIPPI  
 BOARD OF WATER COMMISSIONERS  
 416 North State Street  
 Jackson, Mississippi 39201

WATER WELL DRILLERS LOG

5-30 19 80 F. Gould well serv Walthall  
 date well completed firm name county well located

LANDOWNER:

Doris Alfred

R.R. Lytle  
 (mailing address)

description of formations encountered

from to

Red clay

0 20

Red sand

20 40

Coarse sand & gravel

40 60

WELL LOCATION:

sec. 4 T. 3 N R. 10 E  
                   S                  W  
2 miles NE of Dixon  
 (distance) (direction) (nearest town)

WELL PURPOSE: Home  
 (home, irrigation, municipal, industrial)

WELL COMPLETION DATA:

- (1) diameter (inches) 4
- (2) total depth (feet) 60
- (3) static water level (feet) 40 below above top of ground.
- (4) casing PVC, 52,  
 (material) (depth)  
4 if telescope see back.  
 (size)
- (5) screen 8, 52  
 (length) (depth to top)  
4, PVC  
 (size) (material)
- (6) pump 1/2 10  
 (HP) (yield gpm)  
Ele  
 (type power)
- (7) electric log Y  
 (yes or no)  
 (organization running log)
- (8) how well bottom plugged Sand fill

DRILLERS REMARKS:


DEPT. OF NATURAL RESOURCES  
 BUREAU OF LAND & WATER RESOURCES

JUN 20 1980

RECEIVED

If well telescopes please sketch and show depths.

GROUND LEVEL

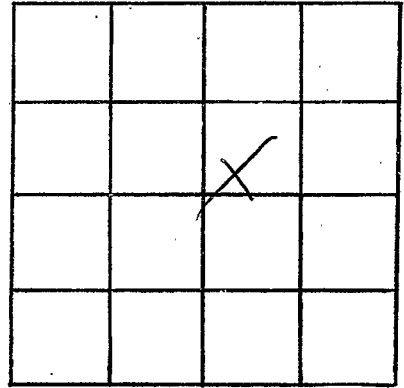

SECTION 4

Please indicate well location X.

ADDITIONAL INFORMATION

If more than one screen, show locations of each on sketch.