

W. H. Hall
 C. M. B.
 204
 6-12-80

MISSISSIPPI
 BOARD OF WATER COMMISSIONERS
 416 North State Street
 Jackson, Mississippi 39201


WATER WELL DRILLERS LOG

6-12 1980 date well completed
 W. H. Hall firm name
 Walthall county well located

LANDOWNER:	description of formations encountered	from	to
Steve Connelly RR-1 (mailing address)	Red Clay Red Sand Coarse Sand & Gravel	0 20 130	25 130 141
WELL LOCATION: sec. 2 T. 3(N) S. R. 16(E) W. 3 5 miles NE of Solum (distance) (direction) (nearest town)			
WELL PURPOSE: (home, irrigation, municipal, industrial)			
WELL COMPLETION DATA: (1) diameter (inches) 4 (2) total depth (feet) 141 (3) static water level (feet) 90 below above top of ground. (4) casing PVC, 133 (material) (depth) 4 (size) if telescope see back. (5) screen 8, 133 (length) (depth to top) 4 (size) PVC (material) (6) pump 1/2, 10 (HP) (yield gpm) alu (type power) (7) electric log no (yes or no) (organization running log) (8) how well bottom plugged Solum			
DRILLERS REMARKS:	DEPT. OF NATURAL RESOURCES BUREAU OF LAND & WATER RESOURCES JUN 20 1980 RECEIVED		

If well telescopes please sketch and show depths.

GROUND LEVEL

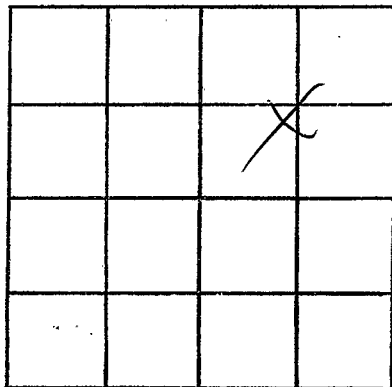

SECTION 2

Please indicate well location X.

ADDITIONAL INFORMATION

If more than one screen,
show locations of each on sketch.