

**WALTHALL**  
**C 2043**  
**10-22-80**

MISSISSIPPI  
 BOARD OF WATER COMMISSIONERS  
 416 North State Street  
 Jackson, Mississippi 39201

**WATER WELL DRILLERS LOG**

10-22-1980 date well completed  
 80 Fitzmaurice Well Serv firm name  
 Walthall county well located

LANDOWNER:	description of formations encountered	from	to
One Andrews	Red clay	0	20
R.B. Tylertown (mailing address)	Red sand & gravel Coarse sand & gravel	20	170
<b>WELL LOCATION:</b> sec. 14 T. 3 N R. 10 E S                  W 8 miles N of Tylertown (distance) (direction) (nearest town)			
<b>WELL PURPOSE:</b> Home (home, irrigation, municipal, industrial)			
<b>WELL COMPLETION DATA:</b> (1) diameter (inches) 4 (2) total depth (feet) 140 (3) static water level (feet) 90 below top of ground. (4) casing PVC, 132 (depth), 4 (size) if telescope see back. (5) screen 8, 132 (length), (depth to top), 4 (size), PVC (material) (6) pump 1/2 (HP), 10 (yield gpm), Elc (type power) (7) electric log No (yes or no) (organization running log) (8) how well bottom plugged Seal block			

DEPT. OF NATURAL RESOURCES  
 BUREAU OF LAND & WATER RESOURCES


DEC - 9 1980

RECEIVED

DRILLERS REMARKS:

If well telescopes please sketch and show depths.

GROUND LEVEL

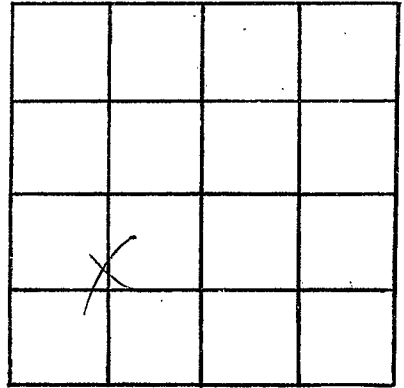

SECTION 14

Please indicate well location X.

ADDITIONAL INFORMATION

If more than one screen, show locations of each on sketch.