

MISSISSIPPI DEPARTMENT OF NATURAL RESOURCES

Bureau of Land and Water Resources

Southport Mall

P.O. Box 10631

Jackson, Mississippi 39209

WATER WELL DRILLERS LOG

WALTHALL
C 2045
2-14-80

Feb-14 19 80 Reuss Miller Walthall
 date well completed firm name county well located

LANDOWNER:
Rubin Halmes
Rt 3 - Tylitonia
 (mailing address)

WELL LOCATION:
 sec. 34 T. 3 N R. 10 E
5 1/2 miles N-NW of Tylitonia
 (distance) (direction) (nearest town)

WELL PURPOSE: Residential
 (home, irrigation, municipal, industrial)

WELL COMPLETION DATA:

(1) diameter (inches) 4"

(2) total depth (feet) 142

(3) static water level (feet) 80 below above-top of ground.

(4) casing plastic bottom
 (material) (depth)
L (size) if telescope see back.

(5) screen 5' 13.7'
 (length) (depth to top)
5' plastic
 (size) (material)

(6) pump 1/2 HP 10
 (HP) (yield gpm)
split
 (type power)

(7) electric log no
 (yes or no)

(organization running log)

description of formations encountered	from	to
<u>Red clay</u>	<u>0</u>	<u>17</u>
<u>Red sand</u>	<u>17</u>	<u>85</u>
<u>Gravel sand</u>	<u>85</u>	<u>98</u>
<u>Clay</u>	<u>98</u>	<u>130</u>
<u>sand & gravel</u>	<u>130</u>	<u>142</u>

(8) how well bottom plugged Backhoe Waller

DRILLERS REMARKS:


DEPT. OF NATURAL RESOURCES
 BUREAU OF LAND & WATER RESOURCES

NOV 14 1980

RECEIVED

If well telescopes please
sketch and show depths.

GROUND LEVEL

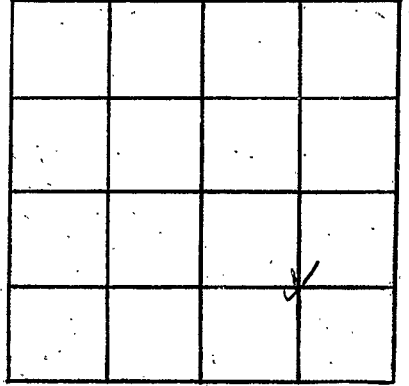

SECTION 34

Please indicate well location X.

ADDITIONAL INFORMATION

If more than one screen,
show locations of each on sketch.