

Bureau of Land and Water Resources

Southport Mall

P.O. Box 10631


Jackson, Mississippi 39209

WATER WELL DRILLERS LOG

WATHALL
 C2057
 10-30-80


Oct 30 1980 News Well Ser Wathall
 date well completed firm name county well located

LANDOWNER:	description of formations encountered	from	to
<p>J. W. Magee Rt 3 Tyltown (mailing address)</p>	<p>Red sandy clay Red sand Gravel & sand Gravel Red Chalk Red sand Coarse sand</p>	<p>0 27 87 90 135</p>	<p>27 87 90 135 142</p>
<p>WELL LOCATION: sec. <u>11</u> T. <u>3</u> N R. <u>10</u> E 8 1/2 miles north of Tyltown (distance) (direction) (nearest town)</p>			
<p>WELL PURPOSE: <u>Trailer</u> (home, irrigation, municipal, industrial)</p>			
<p>WELL COMPLETION DATA:</p> <p>(1) diameter (inches) <u>4"</u></p> <p>(2) total depth (feet) <u>142'</u></p> <p>(3) static water level (feet) <u>80</u> below top of ground.</p> <p>(4) casing <u>plastic bottom</u> (material) (depth)</p> <p><u> </u> if telescope see back. (size)</p> <p>(5) screen <u>5'</u> <u>137'</u> (length) (depth to top)</p> <p><u>4"</u> <u>plastic</u> (size) (material)</p> <p>(6) pump <u>hyattus</u> (HP) (yield gpm)</p> <p><u>elct</u> (type power)</p> <p>(7) electric log <u>w</u> (yes or no)</p> <p><u> </u> (organization running log)</p> <p>(8) How well bottom plugged: <u>back wash</u></p>			
<p>DRILLERS REMARKS: <u> </u></p>			

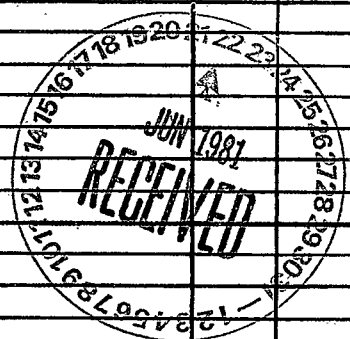

If well telescopes please sketch and show depths.

GROUND LEVEL

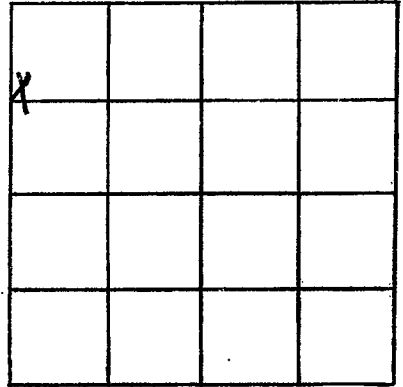

SECTION 11

Please indicate well location X.

ADDITIONAL INFORMATION

If more than one screen,
show locations of each on sketch.