

WALTHALL
 C 2049
 8-18-80

MISSISSIPPI
 BOARD OF WATER COMMISSIONERS
 416 North State Street
 Jackson, Mississippi 39201

WATER WELL DRILLERS LOG

Aug 18 1980 Pleuro mill in Walthall
 date well completed firm name county well located

LANDOWNER:

Wallace Bridges
Rt 3 Tylertown
 (mailing address)

description of formations encountered

from to

<u>red clay</u>	<u>0</u>	<u>24</u>
<u>red loamy sand</u>	<u>24</u>	<u>108</u>
<u>pink chalk</u>	<u>108</u>	<u>115</u>
<u>coarse sand</u>	<u>115</u>	<u>130</u>

WELL LOCATION:

sec. 2 T. 3 N R. 10 E
10 miles North of Tylertown
 (distance) (direction) (nearest town)

WELL PURPOSE: Trailer
 (home, irrigation, municipal, industrial)

WELL COMPLETION DATA:

- (1) diameter (inches) 4"
- (2) total depth (feet) 130'
- (3) static water level (feet) 98 below top of ground.
- (4) casing plastic baton
 (material) (depth)
 (size) If telescope see back.
- (5) screen 5' 125'
 (length) (depth to top)
4" plastic
 (size) (material)
- (6) pump 1/2 10
 (HP) (yield gpm)
chest
 (type power)
- (7) electric log no
 (yes or no)
 (organization running log)

(8) how well bottom plugged backwash valve

DRILLERS REMARKS:


DEPT. OF NATURAL RESOURCES
 BUREAU OF LAND & WATER RESOURCES

MAY 14 1981

RECEIVED

If well telescopes please sketch and show depths.

GROUND LEVEL

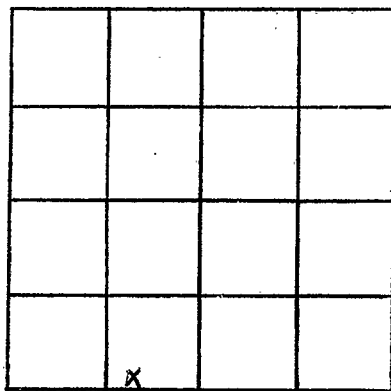

SECTION 2

Please indicate well location X.

ADDITIONAL INFORMATION

If more than one screen, show locations of each on sketch.