

WALTHALL  
 C 2000  
 4-20-81

MISSISSIPPI  
 BOARD OF WATER COMMISSIONERS  
 416 North State Street  
 Jackson, Mississippi 39201

WATER WELL DRILLERS LOG

4-20 1981 *Fitzgerald Well Serv* *Walthall*  
 date well completed firm name county well located

LANDOWNER:	description of formations encountered	from	to
<i>Alvin Courcy</i>			
<i>R.R. Tylstra</i> (mailing address)	<i>Red clay</i>	<i>0</i>	<i>20</i>
	<i>Red sand</i>	<i>20</i>	<i>120</i>
	<i>Coarse sandstone</i>	<i>120</i>	<i>138</i>

LANDOWNER:

description of formations encountered

from

to

*Alvin Courcy*

*R.R. Tylstra*  
(mailing address)

*Red clay*  
*Red sand*

*Coarse sandstone*

*0 20*  
*20 120*  
*120 138*

WELL LOCATION:

sec. 1 T 3 N R 10 E  
 S W  
7 miles N of Tylstra  
 (distance) (direction) (nearest town)

WELL PURPOSE:

(home, irrigation, municipal, industrial)

WELL COMPLETION DATA:

- (1) diameter (inches) 4
- (2) total depth (feet) 138
- (3) static water level (feet) 90 below above top of ground.
- (4) casing PVC 130, (material) (depth)  
4 (size) if telescope see back.
- (5) screen 8 130, (length) (depth to top)  
4 (size) PVC (material)
- (6) pump 1/2 60, (HP) (yield gpm)  
Oh (type power)
- (7) electric log no (yes of no)  
South (organization running log)
- (8) how well bottom plugged South


DRILLERS REMARKS:

DEPT. OF NATURAL RESOURCES  
 BUREAU OF LAND & WATER RESOURCES

APR 29 1981  
 RECEIVED

If well telescopes please sketch and show depths.

GROUND LEVEL

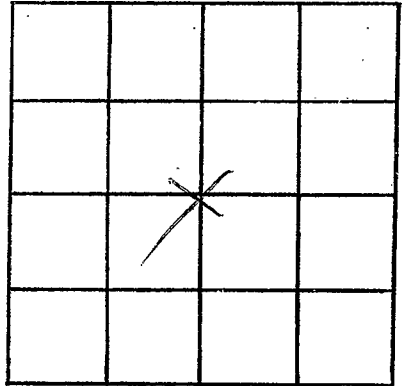

SECTION 1

Please indicate well location X.

ADDITIONAL INFORMATION

If more than one screen,  
show locations of each on sketch.