

Walthall  
C 2051  
9-28-81

MISSISSIPPI  
BOARD OF WATER COMMISSIONERS  
416 North State Street  
Jackson, Mississippi 39201

WATER WELL DRILLERS LOG

9-28 19 81 Fitzgerald Well Service Walthall  
date well completed firm name county well located

LANDOWNER:	description of formations encountered	from	to
<u>Nellie Simon</u>			
<u>R.R. Tylertown</u> (mailing address)	<u>Red clay</u>	<u>0</u>	<u>20</u>
	<u>Red sand &amp; clay</u>	<u>20</u>	<u>110</u>
	<u>Coarse sand &amp; gravel</u>	<u>110</u>	<u>120</u>
WELL LOCATION: sec <u>2</u> T <u>3</u> <u>N</u> <u>S</u> R <u>10</u> <u>E</u> <u>W</u>			
<u>9</u> miles <u>N</u> of <u>Tylertown</u> (distance) (direction) (nearest town)			
WELL PURPOSE: <u>Home</u> (home, irrigation, municipal, industrial)			
WELL COMPLETION DATA:			
(1) diameter (inches) <u>4</u>			
(2) total depth (feet) <u>120</u>			
(3) static water level (feet) <u>95</u> below above top of ground.			
(4) casing <u>POC</u> , <u>112</u> (material) (depth)			
<u>4</u> if telescope see back. (size)			
(5) screen <u>8</u> , <u>112</u> (length) (depth to top)			
<u>4</u> , <u>POC</u> (size) (material)			
(6) pump <u>1/2</u> , <u>10</u> (HP) (yield gpm)			
<u>electric</u> (type power)			
(7) electric log <u>no</u> (yes or/no)			
(organization running log)			
(8) how well bottom plugged <u>Red clay</u>			

DRILLERS REMARKS:  

---


---

---

DEPT. OF NATURAL RESOURCES  
BUREAU OF LAND & WATER RESOURCES  
NOV 20 1981  
RECEIVED

If well telescopes please sketch and show depths.

GROUND LEVEL

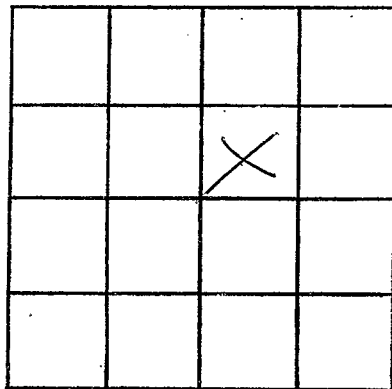

SECTION 2

Please indicate well location X.

ADDITIONAL INFORMATION

If more than one screen, show locations of each on sketch.