

Walthall
 C 2053

MISSISSIPPI
 BOARD OF WATER COMMISSIONERS
 416 North State Street
 Jackson, Mississippi 39201

WATER WELL DRILLERS LOG

10-1 1982 Fitzgerald Well Co Walthall
 date well completed firm name county well located

LANDOWNER:	description of formations encountered	from	to
Bessie Pittman	Red Clay	0	20
B.R. Taylor (mailing address)	Red Sand Coarse Sand & Gravel	20	135
WELL LOCATION:			
sec. 1 T 3 N R 10 E S W 5 miles SSE of Prichard (distance) (direction) (nearest town)			
WELL PURPOSE: (home, irrigation, municipal, industrial)			
WELL COMPLETION DATA:			
(1) diameter (inches) 4			
(2) total depth (feet) 135			
(3) static water level (feet) 80 below top of ground.			
(4) casing PVC, 127, (material) (depth)			
4 (size) If telescope see back.			
(5) screen 8, 127 (length) (depth to top)			
4, PVC (size) (material)			
(6) pump 1/2, 10 (HP) (yield gpm)			
Elec (type power)			
(7) electric log No (yes or no)			
(Organization running log)			
(8) how well bottom plugged Seal			
DRILLERS REMARKS:			


DEPT. OF NATURAL RESOURCES
 BUREAU OF LAND & WATER RESOURCES

OCT 18 1982

RECEIVED

If well telescopes please sketch and show depths.

GROUND LEVEL

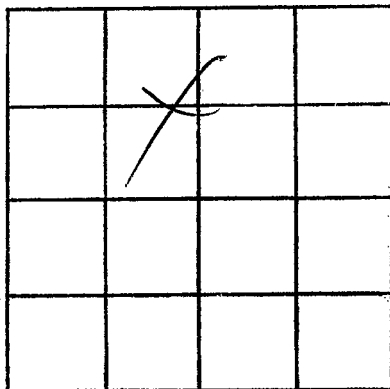

SECTION 1

Please indicate well location X.

ADDITIONAL INFORMATION

If more than one screen, show locations of each on sketch.