

**MISSISSIPPI DEPARTMENT OF NATURAL RESOURCES**  
**Bureau of Land and Water Resources**  
 Southport Mall  
 P.O. Box 10631  
 Jackson, Mississippi 39209  
**WATER WELL DRILLERS LOG**

*Walsh*  
*Cross*

3-14 1983 *F. G. Walsh & Sons* *Walsh*  
 date well completed firm name county well located

LANDOWNER:  
*Billy Boyd*  
*RR. 1, Lumberton*  
 (mailing address)

description of formations encountered	from to	
	ft	ft
<i>Red Clay</i>	<i>0</i>	<i>20</i>
<i>Red sand</i>	<i>20</i>	<i>90</i>
<i>Coarse sand &amp; gravel</i>	<i>90</i>	<i>138</i>

WELL LOCATION:  
 sec. *33* T *3* N R *10* E  
                   S                  W  
*8* miles *WNW* of *Lumberton*  
 (distance) (direction) (nearest town)

WELL PURPOSE:  
*Home*  
 (home, irrigation, municipal, industrial)

- WELL COMPLETION DATA:
- (1) diameter (inches) 4
  - (2) total depth (feet) 138
  - (3) static water level (feet) 118 below above top of ground.
  - (4) casing PVC, 130,  
 (material) (depth)  
4 if telescope see back.  
 (size)
  - (5) screen 8, 130  
 (length) (depth to top)  
4, PVC  
 (size) (material)
  - (6) pump 1/2, 10  
 (HP) (yield gpm)  
9kw  
 (type power)
  - (7) electric log no  
 (yes or no)  
 (organization running log)
  - (8) how well bottom plugged Sand Shk

DRILLERS REMARKS:


DEPT. OF NATURAL RESOURCES  
 BUREAU OF LAND & WATER RESOURCES

MAY 9 1983

**RECEIVED**

If well telescopes please sketch and show depths.

GROUND LEVEL

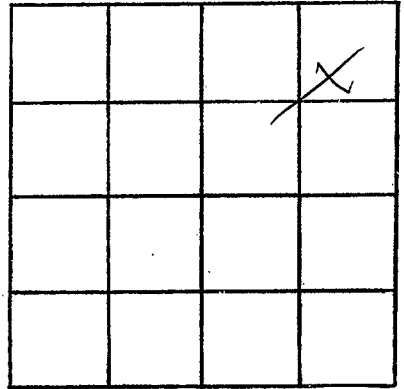

SECTION 33

Please indicate well location X.

ADDITIONAL INFORMATION

If more than one screen,  
show locations of each on sketch.