

Walshall
2080

MISSISSIPPI DEPARTMENT OF NATURAL RESOURCES
Bureau of Land and Water Resources
Southport Mall
P.O. Box 10631
Jackson, Mississippi 39209
WATER WELL DRILLERS LOG

April 30, 1983 Reems Well, Inc. Walshall
date well completed firm name county well located

LANDOWNER:
Floyd A. Martin
At 3 Tyletown
(drilling address)

description of formations encountered	from to	
Clay	0	17
Red Chalky sand	17	58
Gravel & sand	58	70
Chalk & sand	70	105
Gravel & sand	105	125

WELL LOCATION:
sec. 21 T-3 N R-10 E
8 miles N-NW of Tyletown
(distance) (direction) (nearest town)

WELL PURPOSE: house
(home, irrigation, municipal, industrial)

- WELL COMPLETION DATA:
- (1) diameter (inches) 4"
 - (2) total depth (feet) 125'
 - (3) static water level (feet) 70 below top of ground.
 - (4) casing Plastic, bottom
(material) (depth)
 - (5) screen 5' 120'
(length) (depth to top)
 - (6) pump 4" plastic
(size) (material)
 - (7) pump 1/2 gyathus
(HP) (yield gpm)
 - elect
(type power)
 - (8) electric log no
(yes or no)
 - (organization running log)
 - (9) how well bottom plugged back wash

DRILLERS REMARKS:


DEPT. OF NATURAL RESOURCES
BUREAU OF LAND & WATER RESOURCES

JUL 5 1983

RECEIVED

If well telescopes please sketch and show depths.

GROUND LEVEL

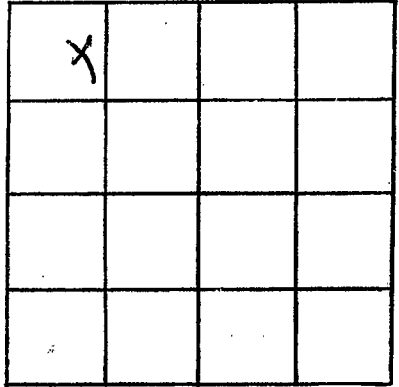

SECTION 21

Please indicate well location X.

ADDITIONAL INFORMATION

If more than one screen, show locations of each on sketch.