

MISSISSIPPI DEPARTMENT OF NATURAL RESOURCES
Bureau of Land and Water Resources
Southport Mall
P.O. Box 10631
Jackson, Mississippi 39209
WATER WELL DRILLERS LOG

Walthall
C-2057

5-17
 date well completed

1983 Felquablell Sew
 firm name

Walthall
 county well located

LANDOWNER:

Hollis Peterson

R.R. Lyntown
 (mailing address)

description of formations encountered

from to

<u>Red clay</u>	<u>0</u>	<u>20</u>
<u>Red sand</u>	<u>20</u>	<u>60</u>
<u>white chalk</u>	<u>60</u>	<u>155</u>
<u>Coarse sandy gravel</u>	<u>155</u>	<u>168</u>

WELL LOCATION:

sec. 13 T. 3 N R. 10 E
S W
6 miles S of Pinola
 (distance) (direction) (nearest town)

WELL PURPOSE:

Home
 (home, irrigation, municipal, industrial)

WELL COMPLETION DATA:

- (1) diameter (inches) 4
- (2) total depth (feet) 168
- (3) static water level (feet) 97 below above top of ground.
- (4) casing PVC, 160,
 (material) (depth)
4 if telescope see back.
 (size)
- (5) screen 8, 160
 (length) (depth to top)
4, PVC
 (size) (material)
- (6) pump 1/2, 10
 (HP) (yield gpm)
Electric
 (type power)
- (7) electric log no
 (yes or no)
no
 (organization running log)
- (8) how well bottom plugged Sealed

DEPT. OF NATURAL RESOURCES
 BUREAU OF LAND & WATER RESOURCES


JUL 17 1983

RECEIVED

DRILLERS REMARKS:

If well telescopes please sketch and show depths.

GROUND LEVEL

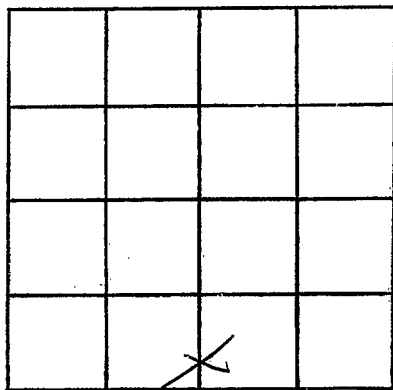

SECTION 13

Please indicate well location X.

ADDITIONAL INFORMATION

If more than one screen,
show locations of each on sketch.