

MISSISSIPPI DEPARTMENT OF NATURAL RESOURCES

Bureau of Land and Water Resources

Southport Mall

P.O. Box 10631

Jackson, Mississippi 39209

WATER WELL DRILLERS LOG

Walshall
C 2058

11-9 date well completed 19 83 Fitzgerald well sh firm name walshall county well located

LANDOWNER: Chester Houston
R.R. 3 Hylatown
 (mailing address)

description of formations encountered	from	to
<u>Red clay</u>	<u>0</u>	<u>20</u>
<u>Red sand</u>	<u>20</u>	<u>90</u>
<u>Coarse sand & gravel</u>	<u>90</u>	<u>135</u>

WELL LOCATION:
 sec. 1 T. 3 N. R. 9 E
5 miles SSE of Prindale
 (distance) (direction) (nearest town)

WELL PURPOSE: Home
 (home, irrigation, municipal, industrial)

WELL COMPLETION DATA:

(1) diameter (inches) 4

(2) total depth (feet) 135

(3) static water level (feet) 85 below top of ground.

(4) casing PVC, 127,
 (material) (depth)
4 if telescope see back.
 (size)

(5) screen 8, 127,
 (length) (depth to top)
4, PVC
 (size) (material)

(6) pump 1/2, 10
 (HP) (yield gpm)
Electric
 (type power)

(7) electric log no
 (yes or no)
no
 (organization running log)

(8) how well bottom plugged hard plug

DEPT. OF NATURAL RESOURCES
 BUREAU OF LAND & WATER RESOURCES


DEC 9 1983

RECEIVED

DRILLERS REMARKS:

If well telescopes please sketch and show depths.

GROUND LEVEL

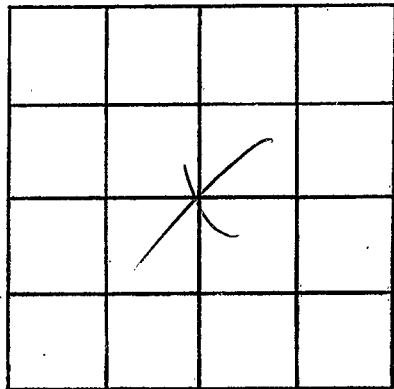

SECTION 1

Please indicate well location X.

ADDITIONAL INFORMATION

If more than one screen,
show locations of each on sketch.