

Walthall  
 C  
 2089

MISSISSIPPI DEPARTMENT OF NATURAL RESOURCES  
 Bureau of Land and Water Resources  
 Southport Mall  
 P.O. Box 10631  
 Jackson, Mississippi 39209  
 WATER WELL DRILLERS LOG

5-24  
 date well completed

1983 Fitzgerald  
 firm name

Walthall  
 county well located

LANDOWNER:  
 Langston Hill ch.  
 RR- Lytle  
 (mailing address)

description of formations encountered	from	to
	Red clay Coarse sand & gravel	6 20

WELL LOCATION:  
 sec. 36 T 3 N R 9 E  
 S W  
 9 miles W of Lytle  
 (distance) (direction) (nearest town)

WELL PURPOSE:  
 (home, irrigation, municipal, industrial)

- WELL COMPLETION DATA:
- (1) diameter (inches) 4
  - (2) total depth (feet) 55
  - (3) static water level (feet) 25 below above top of ground.
  - (4) casing PVC, 47 (material) (depth)  
 4 (size) if telescope see back.
  - (5) screen 8, 47 (length) (depth to top)  
 4 (size) PVC (material)
  - (6) pump 1/2, 10 (HP) (yield gpm)  
 electric (type power)
  - (7) electric log yes or no
  - (8) how well bottom plugged

DRILLERS REMARKS:


DEPT. OF NATURAL RESOURCES  
 BUREAU OF LAND & WATER RESOURCES

JUL 11 1983

RECEIVED

If well telescopes please sketch and show depths.

GROUND LEVEL

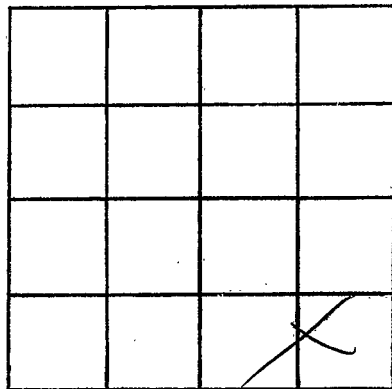

SECTION 36

Please indicate well location X.

ADDITIONAL INFORMATION

If more than one screen,  
show locations of each on sketch.