

MISSISSIPPI DEPARTMENT OF NATURAL RESOURCES

Bureau of Land and Water Resources

Southport Mall

P.O. Box 10631

Jackson, Mississippi 39209

WATER WELL DRILLERS LOG

Walthall
AC
2000

6-22 1983
date well completed

Fitzwell Well Serv Walthall
firm name county well located

LANDOWNER:
Bill Feske
P.R. Jagers, ms.
(mailing address)

description of formations encountered	from	to
Red clay	0	20
Red sand	20	115
Coarse sand & gravel	115	128

WELL LOCATION:
sec. 3 T-3 N R-10 E
S W
9 miles N of Lighter
(distance) (direction) (nearest town)

WELL PURPOSE: Home
(home, irrigation, municipal, industrial)

- WELL COMPLETION DATA:
- (1) diameter (inches) 4
 - (2) total depth (feet) 128
 - (3) static water level (feet) 90 below above top of ground.
 - (4) casing PVC, 120 (material), (depth), 4 (size) if telescope see back.
 - (5) screen 8, 120 (length), (depth to top), 4 (size), PVC (material)
 - (6) pump 1/2 (HP), 10 (yield gpm), Elu (type power)
 - (7) electric log (yes or no) no
(organization running log)
 - (8) how well bottom plugged Sand

DRILLERS REMARKS:


DEPT. OF NATURAL RESOURCES
BUREAU OF LAND & WATER RESOURCES

JUL 11 1983

RECEIVED

If well telescopes please sketch and show depths.

GROUND LEVEL

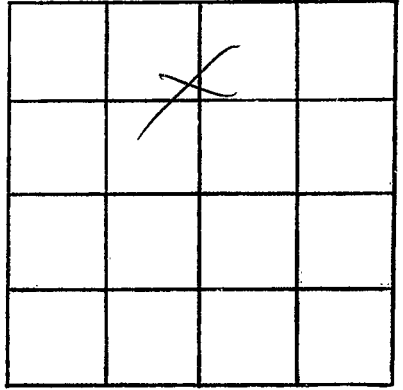

SECTION 3

Please indicate well location X.

ADDITIONAL INFORMATION

If more than one screen,
show locations of each on sketch.