

MISSISSIPPI DEPARTMENT OF NATURAL RESOURCES

Bureau of Land and Water Resources

Southport Mall.

P.O. Box 10631

Jackson, Mississippi 39209

WATER WELL DRILLERS LOG

Walthall
EC
2001

6-2 19 83 Fitzgerald Walthall
 date well completed firm name county well located

LANDOWNER:
Hip Holmes
RR- Lyketown, ms.
 (mailing address)

description of formations encountered	from to	
	feet	feet
<u>Red Clay</u>	<u>0</u>	<u>20</u>
<u>Red Sand</u>	<u>20</u>	<u>80</u>
<u>Concrete Sand & Gravel</u>	<u>80</u>	<u>115</u>

WELL LOCATION:
 sec. 28 T 3 N R 10 E
S W
5 miles NW of Lyketown
 (distance) (direction) (nearest town)

WELL PURPOSE:
Home
 (home, irrigation, municipal, industrial)

- WELL COMPLETION DATA:
- (1) diameter (inches) 4
 - (2) total depth (feet) 115
 - (3) static water level (feet) 85 below above top of ground.
 - (4) casing PVC 107
 (material) (depth)
4 if telescope see back.
 (size)
 - (5) screen 8 107
 (length) (depth to top)
4 PVC
 (size) (material)
 - (6) pump 1/2 10
 (HP) (yield gpm).
Electric
 (type power)
 - (7) electric log No
 (yes or no)
 (organization running log)
 - (8) how well bottom plugged Sand Sh

DRILLERS REMARKS:


DEPT. OF NATURAL RESOURCES
 BUREAU OF LAND & WATER RESOURCES

11 1983

RECEIVED

If well telescopes please sketch and show depths.

GROUND LEVEL

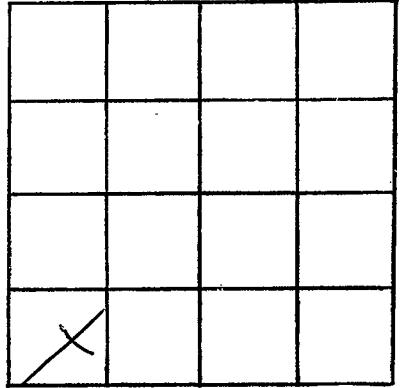

SECTION 28

Please indicate well location X.

ADDITIONAL INFORMATION

If more than one screen, show locations of each on sketch.