

MISSISSIPPI DEPARTMENT OF NATURAL RESOURCES

Bureau of Land and Water Resources

Southport Mall

P.O. Box 10631

Jackson, Mississippi 39209

WATER WELL DRILLERS LOG

Walthall  
C 2002

Nov-26  
 date well completed

1983 Rivers Well Ser.  
 firm name

Walthall  
 county well located

LANDOWNER:	description of formations encountered	from	to
<u>Peter Brumfield</u> <u>Rt Tylertown</u> (mailing address)	<u>red clay</u> <u>red sand + clay</u> <u>small gravel</u>	0	18
WELL LOCATION: sec. <u>32</u> T- <u>3</u> N R- <u>10</u> E <u>5</u> miles <u>N-NW</u> of <u>Tylertown</u> (distance) (direction) (nearest town)		18	90
WELL PURPOSE: <u>house</u> (home, irrigation, municipal, industrial)		90	98
WELL COMPLETION DATA: (1) diameter (inches) <u>4"</u> (2) total depth (feet) <u>98</u> (3) static water level (feet) <u>70'</u> below top of ground. (4) casing <u>plastic</u> , <u>bottom</u> (material) (depth) <u>1</u> if telescope see back. (size) (5) screen <u>6'</u> , <u>92'</u> (length) (depth to top) <u>4"</u> , <u>plastic</u> (size) (material) (6) pump <u>1/2</u> HP, <u>10</u> yield gpm (HP) (yield gpm) <u>split</u> (type power) (7) electric log <u>no</u> (yes or no) <u>no</u> (organization running log) (8) how well bottom plugged <u>bad wash</u>			
DRILLERS REMARKS: <u>no</u>			


DEPT. OF NATURAL RESOURCES  
 BUREAU OF LAND & WATER RESOURCES

APR 30 1984

RECEIVED

If well telescopes please sketch and show depths.

GROUND LEVEL

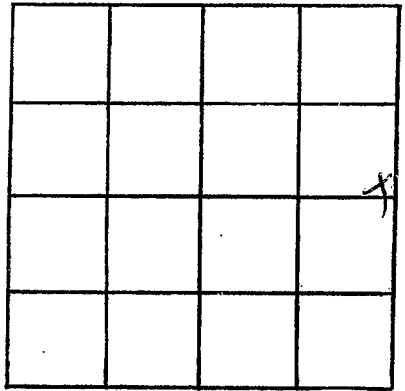

SECTION 33

Please indicate well location X.

ADDITIONAL INFORMATION

If more than one screen,  
show locations of each on sketch.