

WATTHALL  
~~WATTHALL~~  
 C 2224  
 2-21-85

MISSISSIPPI  
 BOARD OF WATER COMMISSIONERS  
 416 North State Street  
 Jackson, Mississippi 39201

WATER WELL DRILLERS LOG

2/21 1985 STAFFORD Well by Wathall  
 date well completed firm name county well located

LANDOWNER: Frank Ripha

description of formations encountered

from to

top soil

0 2

clay

2 50

(mailing address)

WELL LOCATION:

dry sand

50 80

sec 5 T 20 N R 10 E  
 S W

white chalk

80 150

7 miles North of Waltham  
 (distance) (direction) (nearest town)

fine sand

150 180

WELL PURPOSE: Home  
 (home, irrigation, municipal, industrial)

sand & gravel

180 200

WELL COMPLETION DATA:

(1) diameter (inches) 4"

(2) total depth (feet) 200ft

(3) static water level (feet) 110' below above top of ground.

(4) casing plastic, 190'  
 (material) (depth)

4"  
 (size) if telescope see back.

(5) screen 10', 190'  
 (length) (depth to top)

4" plastic  
 (size) (material)

(6) pump 1 (HP) 300 (yield gpm)

elect.  
 (type power)

(7) electric log (yes or no)

(organization running log)

(8) how well bottom plugged Bow

DRILLERS REMARKS:


*[Handwritten signature]*

RECEIVED  
 MAR 22 1985

Department of Natural Resources  
 Bureau of Land & Water Resources

If well telescopes please sketch and show depths.

GROUND LEVEL

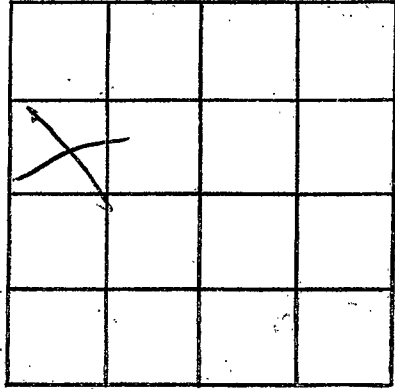

SECTION \_\_\_\_\_

Please indicate well location X.

ADDITIONAL INFORMATION

If more than one screen,  
show locations of each on sketch.