

MISSISSIPPI DEPARTMENT OF NATURAL RESOURCES

Bureau of Land and Water Resources

Southport Mall

P.O. Box 10631

Jackson, Mississippi 39209

WATER WELL DRILLERS LOG

Walthall
Coos
7-16-85

7-16 1985 Fitzgerald Well Serv. Walthall
 date well completed firm name county well located


LANDOWNER:	description of formations encountered	from	to
<u>Emma Smith.</u>	<u>Red clay</u>	<u>0</u>	<u>20</u>
<u>B.R. Fyfe, Jr., M.S.</u> (mailing address)	<u>Red sand</u>	<u>20</u>	<u>90</u>
<u>11</u> miles <u>E</u> of <u>McComb</u> (distance) (direction) (nearest town)	<u>Coarse sand & gravel</u>	<u>90</u>	<u>110</u>
WELL LOCATION: sec. <u>36</u> T <u>3</u> (N) R <u>10</u> (E) <u>11</u> miles <u>E</u> of <u>McComb</u> (distance) (direction) (nearest town)			
WELL PURPOSE: <u>Home</u> (home, irrigation, municipal, industrial)			
WELL COMPLETION DATA:			
(1) diameter (inches) <u>4</u>			
(2) total depth (feet) <u>110</u>			
(3) static water level (feet) <u>77</u> below above top of ground.			
(4) casing <u>PVC</u> , <u>100</u> (material) (depth) <u>4</u> if telescope see back. (size)			
(5) screen <u>10</u> , <u>100</u> (length) (depth to top) <u>4</u> , <u>PVC</u> (size) (material)			
(6) pump <u>1/2</u> , <u>10</u> (HP) (yield gpm) <u>Electric</u> (type power)			
(7) electric log <u>No</u> (yes or no) <u>None</u> (organization running log)			
(8) how well bottom plugged <u>Sand Shale</u>			
DRILLERS REMARKS:			

RECEIVED
 JUL 25 1985

Department of Natural Resources
 Bureau of Land & Water Resources

If well telescopes please sketch and show depths.

GROUND LEVEL

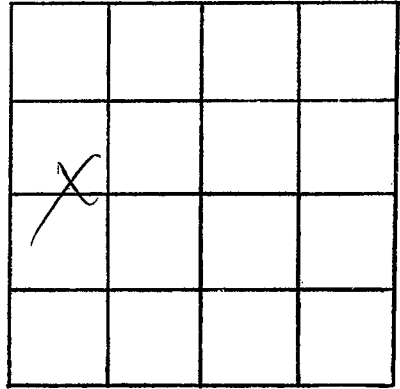

SECTION 36

Please indicate well location X.

ADDITIONAL INFORMATION

If more than one screen,
show locations of each on sketch.