

MISSISSIPPI DEPARTMENT OF NATURAL RESOURCES

Bureau of Land and Water Resources

Southport Mall

P.O. Box 10631

Jackson, Mississippi 39209

WATER WELL DRILLERS LOG

C 2000  
Waltnall  
8-6-85

8-6  
date well completed

1985 *Fitzgerald well*  
firm name

*Waltnall*  
county well located

LANDOWNER:

*James R. Ratchiff*  
*R.R. Lybette, Jr.*  
(mailing address)

description of formations encountered

from

to

<i>Reel clay</i>	<i>0</i>	<i>20</i>
<i>Reel sand</i>	<i>20</i>	<i>85</i>
<i>Coarse sand &amp; gravel</i>	<i>85</i>	<i>100</i>

WELL LOCATION:

sec. *4* T. *3* N. R. *10* E  
S W  
*3* miles *S* of *EMO*  
(distance) (direction) (nearest town)

WELL PURPOSE: *Home*  
(home, irrigation, municipal, industrial)

WELL COMPLETION DATA:

- (1) diameter (inches) *4*
- (2) total depth (feet) *100*
- (3) static water level (feet) *75* below above top of ground.
- (4) casing *PVC*, *90*  
(material), (depth)  
*4*  
(size) if telescope see back.
- (5) screen *10*, *90*  
(length), (depth to top)  
*4*, *PVC*  
(size), (material)
- (6) pump *1/2*, *10*  
(HP), (yield gpm)  
*elec*  
(type power)
- (7) electric log *no*  
(yes or no)  
(organization running log)
- (8) how well bottom plugged *Sand shell*


DRILLERS REMARKS:

RECEIVED  
SEP 13 1985

Department of Natural Resources  
Bureau of Land & Water Resources

If well telescopes please sketch and show depths.

GROUND LEVEL

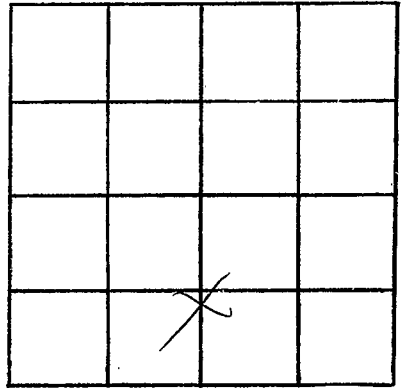

SECTION 4

Please indicate well location X.

ADDITIONAL INFORMATION

If more than one screen,  
show locations of each on sketch.