

~~WALTHALL~~  
~~WALTHALL~~  
 C2907  
 2-26-85

MISSISSIPPI  
 BOARD OF WATER COMMISSIONERS  
 416 North State Street  
 Jackson, Mississippi 39201

WATER WELL DRILLERS LOG

2/26/85 1985 Stafford Drilling Walthall  
 date well completed firm name county well located

LANDOWNER: <u>Engene Brister</u>	description of formations encountered	from	to
	<u>top soil</u>	<u>0'</u>	<u>2'</u>
	<u>red clay</u>	<u>2'</u>	<u>17'</u>
	<u>pea gravel</u>	<u>17'</u>	<u>100'</u>
	<u>sand (dry)</u>	<u>100'</u>	<u>130'</u>
	<u>white chalk</u>	<u>130'</u>	<u>180'</u>
	<u>sandy gravel</u>	<u>180'</u>	<u>230'</u>

(mailing address)  
 WELL LOCATION:  
 sec. 7 T. 3 N. R. 10 E.  
 S. W.  
8 miles west of Hubert  
 (distance) (direction) (nearest town)  
 WELL PURPOSE: home  
 (home, irrigation, municipal, industrial)


- WELL COMPLETION DATA:
- (1) diameter (inches) 4"
  - (2) total depth (feet) 230'
  - (3) static water level (feet) 180 below above top of ground.
  - (4) casing Plastic, 230  
 (material) (depth)  
4"  
 (size) if telescope see back.
  - (5) screen 10', 230'  
 (length) (depth to top)  
4", Plastic  
 (size) (material)
  - (6) pump 1/2, 8  
 (HP) (yield gpm)  
electric  
 (type power)
  - (7) electric log (yes or no) \_\_\_\_\_
  - (organization running log) \_\_\_\_\_
  - (8) how well bottom plugged BWV

DRILLERS REMARKS:  
Wade Brown Assisted  
Erley Hoff

RECEIVED  
 MAR 28 1985  
 Department of Natural Resources  
 Bureau of Land & Water Resources

If well telescopes please sketch and show depths.

GROUND LEVEL

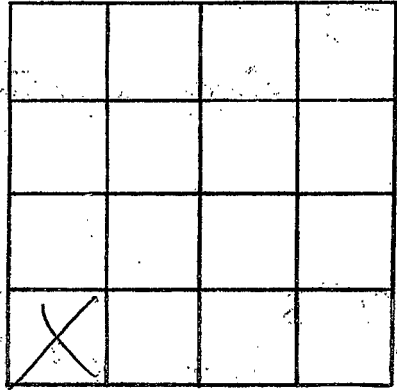

SECTION \_\_\_\_\_

Please indicate well location X.

ADDITIONAL INFORMATION

If more than one screen,  
show locations of each on sketch.