

MISSISSIPPI DEPARTMENT OF NATURAL RESOURCES

Bureau of Land and Water Resources

Southport Mall

P.O. Box 10631

Jackson, Mississippi 39209

WATER WELL DRILLERS LOG

WALTHAM
30069

3-17

date well completed

1986

Fitzgerald Well Sew

firm name

Waltham

county well located

LANDOWNER:

Ch. Leonard

R.R. Lytle town ms.
(mailing address)

description of formations encountered

from

to

Red clay 0 20
fine sand 20 90
Coarse sand & gravel 90 109

WELL LOCATION:

sec. 6 T 3 N R 10 E
S W
3 miles SW of ENOM
(distance) (direction) (nearest town)

WELL PURPOSE:

Home
(home, irrigation, municipal, industrial)

WELL COMPLETION DATA:

- (1) diameter (inches) 4
- (2) total depth (feet) 109
- (3) static water level (feet) 50 below above top of ground.
- (4) casing PVC 99
(material) (depth)
4 if telescope see back.
(size)
- (5) screen 10 99
(length) (depth to top)
4 PVC
(size) (material)
- (6) pump 1/2 10
(HP) (yield gpm)
Ch
(type power)
- (7) electric log no
(yes or no)
(organization running log)
- (8) how well bottom plugged Seal block


RECEIVED
MAY 5 1986

DRILLERS REMARKS:

Department of Natural Resources
Bureau of Land & Water Resources

If well telescopes please sketch and show depths.

GROUND LEVEL

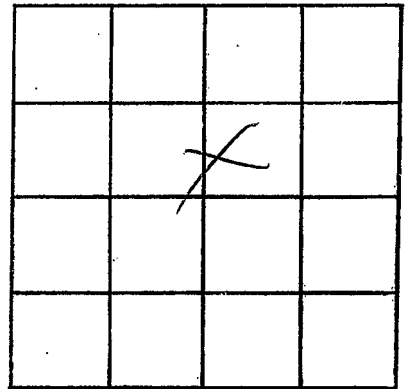

SECTION 6

Please indicate well location X.

ADDITIONAL INFORMATION

If more than one screen, show locations of each on sketch.