

WALTHALL  
C 2000

MISSISSIPPI DEPARTMENT OF NATURAL RESOURCES  
Bureau of Land and Water Resources  
Southport Mall  
P.O. Box 10631  
Jackson, Mississippi 39209  
WATER WELL DRILLERS LOG

7-21 1986 F. Gerald Well Serv Walthall  
date well completed firm name county well located

LANDOWNER:  
Terry Boyel  
R.R. Telecommunications  
(mailing address)

description of formations encountered	from	to
<u>Red clay</u>	<u>0</u>	<u>20</u>
<u>Red sand</u>	<u>20</u>	<u>85</u>
<u>white clay</u>	<u>85</u>	<u>140</u>
<u>Coarse sand &amp; gravel</u>	<u>140</u>	<u>158</u>

WELL LOCATION:  
sec. 6 T. 3 N R. 10 E  
S W  
5 miles SE of Previdale  
(distance) (direction) (nearest town)

WELL PURPOSE:  
Home  
(home, irrigation, municipal, industrial)

- WELL COMPLETION DATA:
- (1) diameter (inches) 4
  - (2) total depth (feet) 158
  - (3) static water level (feet) 80 below above top of ground.
  - (4) casing PVC, 148,  
(material) (depth)  
4  
(size) if telescope see back.
  - (5) screen 10, 148  
(length) (depth to top)  
4, PVC  
(size) (material)
  - (6) pump 1/2, 10  
(HP) (yield gpm)  
elec  
(type power)
  - (7) electric log No  
(yes or no)  
(organization running log)
  - (8) how well bottom plugged Sand block


RECEIVED  
AUG 13 1986

Department of Natural Resources  
Bureau of Land & Water Resources

DRILLERS REMARKS:

If well telescopes please sketch and show depths.

GROUND LEVEL

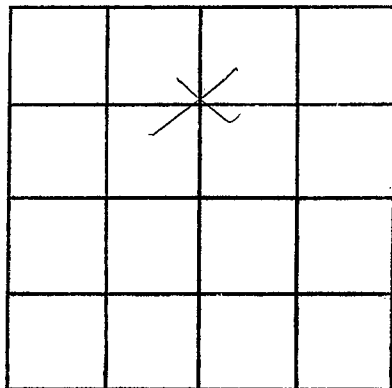

SECTION 6

Please indicate well location X.

ADDITIONAL INFORMATION

If more than one screen,  
show locations of each on sketch.