

MISSISSIPPI DEPARTMENT OF NATURAL RESOURCES

Bureau of Land and Water Resources

Southport Mall

P.O. Box 10631

Jackson, Mississippi 39209

WATER WELL DRILLERS LOG

WALTER
2002


May 11 1987 Fitzgerald Well Inc Walworth
date well completed firm name county well located

LANDOWNER:	description of formations encountered	from	to
<u>Clyde McKelvin</u> <u>R.R. Tylburn ms.</u> (mailing address)			
WELL LOCATION:			
sec. <u>28</u> T. <u>3</u> N R. <u>10</u> E S W			
<u>7</u> miles <u>N</u> of <u>Tylburn</u> (distance) (direction) (nearest town)			
WELL PURPOSE: <u>Home</u> (home, irrigation, municipal, industrial)			
WELL COMPLETION DATA:			
(1) diameter (inches) <u>4</u>			
(2) total depth (feet) <u>136</u>			
(3) static water level (feet) <u>90</u> below top of ground. above			
(4) casing <u>PVC</u> , <u>126</u> , (material) (depth) <u>4</u> if telescope see back. (size)			
(5) screen <u>10</u> , <u>126</u> (length) (depth to top) <u>4</u> , <u>PVC</u> (size) (material)			
(6) pump <u>1/2</u> , <u>10</u> (HP) (yield gpm) <u>etc</u> (type power)			
(7) electric log <u>no</u> (yes or no)			
(organization running log)			
(8) how well bottom plugged <u>Seal plug</u>			
DRILLERS REMARKS:			

RECEIVED
 JUN 15 1987
 Department of Natural Resources
 Bureau of Land & Water Resources

If well telescopes please sketch and show depths.

GROUND LEVEL

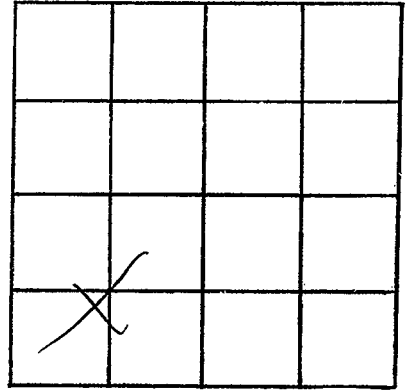

SECTION 28

Please indicate well location X.

ADDITIONAL INFORMATION

If more than one screen,
show locations of each on sketch.