

MISSISSIPPI DEPARTMENT OF NATURAL RESOURCES
Bureau of Land and Water Resources

P.O. Box 10631

Jackson, Mississippi 39209

WATER WELL DRILLERS LOG

COUNTY WELL LOCATED <i>Wellhall</i>		PERMIT NUMBER
WELL NUMBER <i>C</i>	CODED	NAME OF DRILLING FIRM <i>F. T. GERALD</i>
DATE WELL COMPLETED <i>2074</i> <i>Dec 4 - 87</i>		<i>Well Service</i>

NAME & MAILING ADDRESS OF LANDOWNER
Jerry Bayel
RR 3, Tylertown MS

WELL LOCATION: SEC *6* TOWNSHIP *3 N* RANGE *10 E*

DISTANCE *3* Miles DIRECTION *S* of NEAREST TOWN *Edox*

OTHER LANDMARK:

WELL PURPOSE: Home, Irrigation, Municipal, Industrial, Fish Pond, etc.
Home

PUMP DATA

PUMP TYPE (Circle One):
 Submersible Turbine Jet Flowing Well,
Other (Describe) _____

POWER TYPE (Circle One):
 Electric Tractor Diesel Gasoline Butane,
Other (Describe) _____

Pump Capacity (GPM)	No. of Stages	Setting Depth
		FT.

PUMP TEST
Well yielded *10* GPM with
a drawdown of *4* ft.
after *2* hours of pumping

WELL DATA

Well Depth <i>111</i>	Casing Diameter (In.) <i>4</i>	Casing Length (Ft.) <i>101</i>
Type of Casing <i>PVC</i>	Hole Depth <i>111</i>	Depth to Static Water Level <i>81</i>

TYPE OF COMPLETION: (Circle One or More):
 Gravel Packed, Underreamed, Telescoped,
 Natural Development, Open Hole, Other
(Describe) _____

Top of Lap Pipe or Reduction in Casing

FEET	IF TELESCOPED OR MORE THAN ONE SCREEN: USE BACK PAGE
------	--

LOG DATA

TYPE OF LOG RUN (Circle One):
 No Log Run, Electric, Gamma Ray, Density, Sonic, Neutron,
Other (Describe) _____

Name of Organization Running Log

SCREEN DATA

Diameter - Inches <i>4</i>	Length - Feet <i>10</i>	Slot Size - Inches <i>.014</i>
Screen Type <i>PVC</i>	Depth to Bottom - Feet <i>111</i>	

GEOLOGIC DATA (Office Use Only)

Surface Elev.	Geologic Unit	Unit Thickness	Depth to Top
Subs. SWL	Date	Analysis	Aquifer Test


Driller's Remarks

DESCRIPTION OF FORMATIONS ENCOUNTERED	FROM	TO	FORMATIONS (Continued)	FROM	TO
<i>Red clay</i>	<i>0</i>	<i>20</i>			
<i>Red sand</i>	<i>20</i>	<i>100</i>			
<i>Coarse sand</i>	<i>100</i>	<i>111</i>			

IF MORE SPACE IS NEEDED, USE BACK

If well telescopes please
sketch and show depths.

GROUND LEVEL

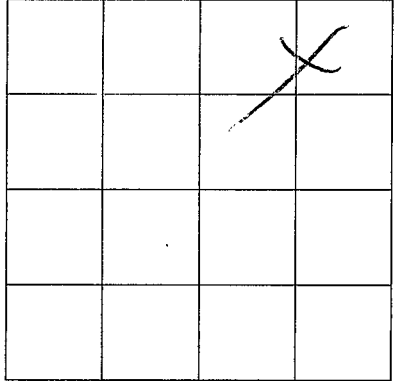

SECTION 6

Please indicate well location X.

ADDITIONAL INFORMATION

If more than one screen,
show location of each on sketch.