

MISSISSIPPI DEPARTMENT OF NATURAL RESOURCES
Bureau of Land and Water Resources
 Southport Mall
 P.O. Box 10631
 Jackson, Mississippi 39209
WATER WELL DRILLERS LOG

Walthall
C 2082

Oct 30 1989 Fitzgerald Well Serv Walthall
 date well completed firm name county well located


LANDOWNER:	description of formations encountered	from	to
<u>A. Jackson</u> <u>R.R. - Tylertown, ms.</u> (mailing address)	<u>Red clay</u> <u>Red gravel</u> <u>White Chalk</u> <u>Common Red gravel</u>	<u>0</u> <u>15</u> <u>45</u> <u>140</u>	<u>15</u> <u>45</u> <u>140</u> <u>155</u>
WELL LOCATION: sec. <u>36</u> T <u>3</u> N R. <u>10</u> E S W <u>8</u> miles <u>W</u> of <u>Tylertown</u> (distance) (direction) (nearest town)			
WELL PURPOSE: <u>Flow</u> (home, irrigation, municipal, industrial)			
WELL COMPLETION DATA:			
(1) diameter (inches) <u>4</u>			
(2) total depth (feet) <u>155</u>			
(3) static water level (feet) <u>60</u> below above top of ground.			
(4) casing <u>PVC</u> <u>145</u> (material) (depth)			
<u>4</u> If telescope see back. (size)			
(5) screen <u>10</u> <u>145</u> (length) (depth to top)			
<u>4</u> <u>PVC</u> (size) (material)			
(6) pump <u>1/2</u> <u>10</u> (HP) (yield gpm)			
<u>etc</u> (type power)			
(7) electric log <u>no</u> (yes or no)			
(organization running log)			
(8) how well bottom plugged <u>hard plug</u>			
DRILLERS REMARKS:			

RECEIVED
 DEC 11 1989

Department of Natural Resources
 Bureau of Land & Water Resources

If well telescopes please sketch and show depths.

GROUND LEVEL

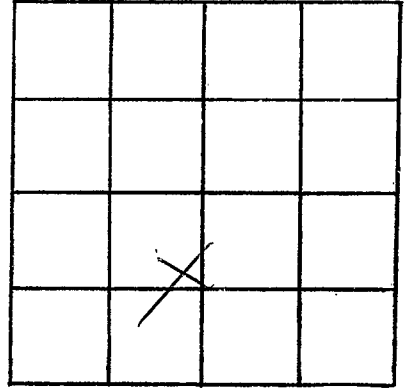

SECTION 36

Please indicate well location X.

ADDITIONAL INFORMATION

If more than one screen,
show locations of each on sketch.