

**MISSISSIPPI DEPARTMENT OF ENVIRONMENTAL QUALITY**  
Bureau of Land and Water Resources

P. O. Box 10631  
Jackson, MS 39289-0631  
**WATER WELL DRILLERS LOG**

COUNTY WELL LOCATED <i>Leflore</i>	
WELL NUMBER <i>2088</i>	CODED
DATE WELL COMPLETED <i>Oct 26 1991</i>	

PERMIT NUMBER
NAME OF DRILLING FIRM <i>Fitzgerald Well Service</i>

NAME & MAILING ADDRESS OF LANDOWNER <i>Earl Hadel</i>		
<i>RR Tyler town, MS.</i>		
WELL LOCATION: SEC	TOWNSHIP	RANGE
<i>15</i>	<i>3</i>	<i>N 10 E</i>
DISTANCE	DIRECTION	NEAREST TOWN
<i>7</i> Miles	<i>NW</i>	of <i>Tylertown.</i>
OTHER LANDMARK		
WELL PURPOSE: Home, Irrigation, Municipal, Industrial, Fish Pond, etc. <i>Home</i>		

<b>PUMP DATA</b>		
PUMP TYPE (Circle One): <input checked="" type="radio"/> Submersible, Turbine, Jet, Flowing Well, Other (Describe) _____		
POWER TYPE (Circle One): <input checked="" type="radio"/> Electric, Tractor, Diesel, Gasoline, Butane, Other (Describe) _____ H/P _____		
Pump Capacity (GPM) <i>10</i>	No. of Stages <i>8</i>	Setting Depth <i>100</i> FT.
PUMP TEST		
Well yielded <i>25</i> GPM with a drawdown of <i>3</i> ft. after <i>2</i> hours of pumping.		

<b>WELL DATA</b>		
Well Depth <i>199</i>	Casing Diameter (In.) <i>4</i>	Casing Length (Ft.) <i>189</i>
Type of Casing <i>PVC</i>	Hole Depth <i>199</i>	Depth to Static Water Level <i>72</i>
TYPE OF COMPLETION: (Circle One or More): <input checked="" type="checkbox"/> Gravel Packed, Underreamed, Telescoped, Natural Development, Open Hole, Other (Describe) _____		
Top of Lap Pipe or Reduction in Casing  FEET <input type="checkbox"/> IF TELESCOPED OR MORE THAN ONE SCREEN: USE BACK PAGE		

<b>LOG DATA</b>	
TYPE OF LOG RUN (Circle One): <input checked="" type="radio"/> No Log Run, Electric, Gamma Ray, Density, Sonic, Neutron, Other (Describe) _____	
Name of Organization Running Log	

<b>SCREEN DATA</b>		
Diameter - inches <i>4</i>	Length - Feet <i>10</i>	Slot Size - inches <i>.014</i>
Screen Type <i>PVC</i>	Depth to Bottom - Feet <i>199</i>	


<b>GEOLOGIC DATA (Office Use Only)</b>			
Surface Elev.	Geologic Unit	Unit Thickness	Depth to Top
Subs. SWL	Date	Analysis	Aquifer Test
Driller's Remarks			

DESCRIPTION OF FORMATIONS ENCOUNTERED	FROM	TO
<i>Red clay</i>	<i>0</i>	<i>20</i>
<i>Red sand</i>	<i>20</i>	<i>100</i>
<i>Red clay</i>	<i>100</i>	<i>180</i>
<i>Red sand</i>	<i>180</i>	<i>190</i>
<i>course sand &amp; gravel</i>	<i>190</i>	<i>199</i>

<b>RECEIVED</b>	
<b>DEC 06 1991</b>	
<b>Dept. of Environmental Quality</b>	
<b>Bureau of Land &amp; Water Resources</b>	
IF MORE SPACE IS NEEDED, USE BACK	

If well telescopes please  
sketch and show depths.

GROUND LEVEL

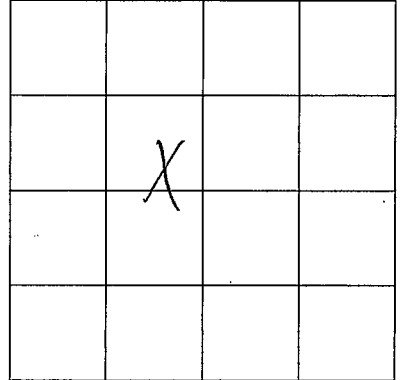

SECTION 15

Please indicate well location X.

ADDITIONAL INFORMATION

If more than one screen,  
show location of each on sketch.