

**MISSISSIPPI DEPARTMENT OF ENVIRONMENTAL QUALITY**

Office of Land and Water Resources

P. O. Box 10631  
Jackson, MS 39289-0631  
**WATER WELL DRILLERS LOG**

COUNTY WELL LOCATED <i>Walthall</i>	
WELL NUMBER <i>C</i>	CODED
DATE WELL COMPLETED <i>NOV 2-93</i>	

PERMIT NUMBER
NAME OF DRILLING FIRM <i>F. T. GERALD Well Serv</i>

NAME & MAILING ADDRESS OF LANDOWNER <i>Jessie Barnes</i> <i>R.R. Tylertown ms.</i>		
WELL LOCATION: SEC	TOWNSHIP	RANGE
<i>1</i>	<i>3</i>	<i>N 10 E</i>
DISTANCE	DIRECTION	NEAREST TOWN
<i>4</i> Miles	<i>S</i>	<i>ENON</i>
OTHER LANDMARK		
WELL PURPOSE: Home, Irrigation, Municipal, Industrial, Fish Pond, etc. <i>Home</i>		

PUMP DATA		
PUMP TYPE (Circle One): <input checked="" type="checkbox"/> Submersible, Turbine, Jet, Flowing Well, Other (Describe)		
POWER TYPE (Circle One): <input checked="" type="checkbox"/> Electric, Tractor, Diesel, Gasoline, Butane, Other (Describe) <i>H/P 1/2</i>		
Pump Capacity (GPM) <i>10</i>	No. of Stages <i>8</i>	Setting Depth <i>75'</i> FT.
PUMP TEST		
Well yielded <i>25</i> GPM with a drawdown of <i>2</i> ft. after <i>2</i> hours of pumping		

WELL DATA		
Well Depth <i>120</i>	Casing Diameter (In.) <i>4</i>	Casing Length (Ft.) <i>110</i>
Type of Casing <i>PUC</i>	Hole Depth <i>120</i>	Depth to Static Water Level <i>33</i>
TYPE OF COMPLETION: (Circle One or More): <input checked="" type="checkbox"/> Gravel Packed, Underreamed, Telescoped, <input type="checkbox"/> Natural Development, <input type="checkbox"/> Open Hole, <input type="checkbox"/> Other (Describe)		

LOG DATA	
TYPE OF LOG RUN (Circle One): Electric, Gamma Ray, Density, Sonic, <input checked="" type="checkbox"/> Neutron, Other (Describe)	
Name of Organization Running Log	

WELL GROUTED TO A DEPTH OF <i>10</i> FEET Type Grout (circle one): Cement, Bentonite, or <input checked="" type="checkbox"/> Mix
---

GEOLOGIC DATA (Office Use Only)			
Surface Elev.	Geologic Unit	Unit Thickness	Depth to Top
Subs. SWL	Date	Analysis	Aquifer Test

SCREEN DATA		
Diameter - Inches <i>4</i>	Length - Feet <i>10</i>	Slot Size - Inches <i>.014</i>
Screen Type <i>PUC</i>	Depth to Bottom - Feet <i>120</i>	


Driller's Remarks

DESCRIPTION OF FORMATIONS ENCOUNTERED	FROM	TO
<i>Red Clay</i>	<i>0</i>	<i>10</i>
<i>Red Sand</i>	<i>10</i>	<i>107</i>
<i>Coarse Sand &amp; gravel</i>	<i>107</i>	<i>120</i>

FORMATIONS (Continued)	FROM	TO
<b>RECEIVED</b>		
<b>JAN 05 1994</b>		
Dept. of Environmental Quality Office of Land & Water Resources		
IF MORE SPACE IS NEEDED, USE BACK		

If well telescopes please sketch and show depths.

GROUND LEVEL

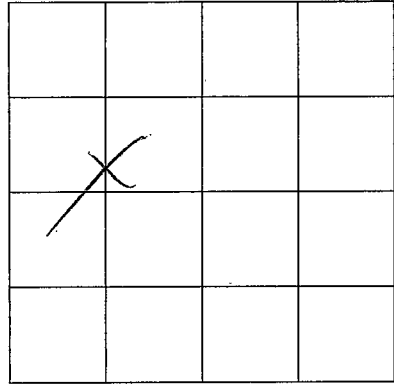

SECTION   /    
Please indicate well location X.

ADDITIONAL INFORMATION

If more than one screen,  
show location of each on sketch.