

WALTHALL
C 2102

MISSISSIPPI
BOARD OF WATER COMMISSIONERS
416 North State Street
Jackson, Mississippi 39201

WATER WELL DRILLERS LOG

APR 28 1994 FITZGERALD Well Service Walthall
date well completed firm name county well located

| LANDOWNER: | description of formations encountered | from | to |
|---|---|-------------------------------------|-------------------------------------|
| <u>Warner Gathin</u> | | | |
| <u>RR-3, Glaton ms.</u> (mailing address) | <u>Red Clay</u> <u>Red Sand</u> <u>Coarse Sand & gravel</u> | <u>12</u> <u>15</u> <u>28</u> | <u>15</u> <u>28</u> <u>92</u> |
| WELL LOCATION: | | | |
| sec. <u>13</u> T <u>3</u> N R <u>10</u> E S W | | | |
| <u>9</u> miles <u>WNW</u> of <u>Glaton</u> (distance) (direction) (nearest town) | | | |
| WELL PURPOSE: <u>flow</u> (home, irrigation, municipal, industrial) | | | |
| WELL COMPLETION DATA: | | | |
| (1) diameter (inches) <u>4</u> | | | |
| (2) total depth (feet) <u>92</u> | | | |
| (3) static water level (feet) <u>79</u> <u>below</u> top of ground. | | | |
| (4) casing <u>PVC</u> , <u>82</u> (material) (depth) | | | |
| <u>4</u> if telescope see back. (size) | | | |
| (5) screen <u>12</u> , <u>82</u> (length) (depth to top) | | | |
| <u>4</u> , <u>PVC</u> (size) (material) | | | |
| (6) pump <u>1/2</u> , <u>10</u> (HP) (yield gpm) | | | |
| <u>clear</u> (type power) | | | |
| (7) electric log <u>no</u> (yes or no) | | | |
| (organization running log) | | | |
| (8) how well bottom plugged <u>sealed</u> | | | |
| DRILLERS REMARKS: | | | |
| | | | |
| | | | |


RECEIVED

JUN 17 1994

Dept. of Environmental Quality
Office of Land & Water Resources

If well telescopes please sketch and show depths.

GROUND LEVEL

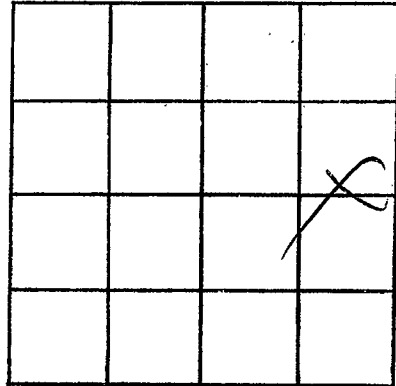

SECTION 83

Please indicate well location X.

ADDITIONAL INFORMATION

If more than one screen,
show locations of each on sketch.