

WALTMALL  
C 2103

MISSISSIPPI  
BOARD OF WATER COMMISSIONERS  
416 North State Street  
Jackson, Mississippi 39201

WATER WELL DRILLERS LOG

APR 29 1994 Fitzgerald Well Serv Walt Mall  
date well completed firm name county well located

LANDOWNER:  
Bertina Gattline  
B.R.3 Eglar  
(mailing address)

description of formations encountered	from	to
<u>Red Clay</u>	<u>75</u>	<u>20</u>
<u>Red Sand</u>	<u>20</u>	<u>80</u>
<u>Green Sand + Gravel</u>	<u>80</u>	<u>94</u>

WELL LOCATION:  
sec. 36 T3 N R 10 E  
S W  
7 miles W of Eglar  
(distance) (direction) (nearest town)

WELL PURPOSE: Home  
(home, irrigation, municipal, industrial)

WELL COMPLETION DATA:  
(1) diameter (inches) 4  
(2) total depth (feet) 94  
(3) static water level (feet) 84 below top of ground.  
(4) casing 152 84  
(material) (depth)  
4 if telescope see back.  
(size)  
(5) screen 10 84  
(length) (depth to top)  
4 102  
(size) (material)  
(6) pump 1/2 10  
(HP) (yield gpm)  
2h  
(type power)  
(7) electric log Yes  
(yes or no)  
(organization running log)  
(8) how well bottom plugged Small

RECEIVED


JUN 17 1994

Dept. of Environmental Quality  
Office of Land & Water Resources

DRILLERS REMARKS:

If well telescopes please sketch and show depths.

GROUND LEVEL

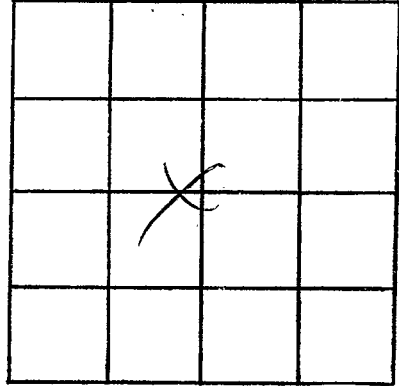

SECTION 36

Please indicate well location X.

ADDITIONAL INFORMATION

If more than one screen,  
show locations of each on sketch.