

MISSISSIPPI DEPARTMENT OF ENVIRONMENTAL QUALITY

Office of Land and Water Resources

P. O. Box 10631
Jackson, MS 39289-0631

WATER WELL DRILLERS LOG

COUNTY WELL LOCATED
WALTON

WELL NUMBER 2104 CODED

DATE WELL COMPLETED
JUN 22 94

PERMIT NUMBER

NAME OF DRILLING FIRM
FITZGERALD Well Serv

NAME & MAILING ADDRESS OF LANDOWNER
PARRELL DIXON
R.R. Tyltton, ms.

WELL LOCATION. SEC 25 TOWNSHIP 3 RANGE 10
N E
S W

DISTANCE 6 Miles 4 Direction of Tyltton NEAREST TOWN

OTHER LANDMARK

WELL PURPOSE: Home, Irrigation, Municipal, Industrial, Fish Pond, etc.
Routiny House

PUMP DATA

PUMP TYPE (Circle One): Submersible, Turbine, Jet, Flowing Well, Other (Describe)

POWER TYPE (Circle One): Electric, Tractor, Diesel, Gasoline, Butane, Other (Describe) H/P 2

Pump Capacity (GPM) 35 No. of Stages 14 Setting Depth 100 FT.

PUMP TEST

Well yielded 50 GPM with a drawdown of 2 ft. after 2 hours of pumping

WELL DATA

Well Depth 160 Casing Diameter (In.) 4 Casing Length (Ft.) 140

Type of Casing PVC Hole Depth 160 Depth to Static Water Level 45

TYPE OF COMPLETION: (Circle One or More): Natural Development, Gravel Packed, Underreamed, Telescoped, Open Hole, Other (Describe)

WELL GROUTED TO A DEPTH OF 10 FEET
Type Grout (circle one): Cement, Bentonite, or Mix

LOG DATA

TYPE OF LOG RUN (Circle One): No Log Run, Electric, Gamma Ray, Density, Sonic, Neutron, Other (Describe)

Name of Organization Running Log

WELL GROUTED TO A DEPTH OF 10 FEET
Type Grout (circle one): Cement, Bentonite, or Mix

GEOLOGIC DATA (Office Use Only)

Surface Elev.	Geologic Unit	Unit Thickness	Depth to Top

Subs. S.W. Date Analysis Aquifer Test

SCREEN DATA

Diameter - Inches 4 Length - Feet 20 Slot Size - Inches 10R

Screen Type PVC Depth to Bottom - Feet 160

Drillers Remarks

RECEIVED

JUL 27 1994

Top of Lap Pipe or Reduction in Casing
Dept. of Environmental Quality
Office of Land and Water Resources


IF TELESCOPED OR MORE THAN ONE SCREEN USE BACK PAGE

DESCRIPTION OF FORMATIONS ENCOUNTERED	FROM	TO	FORMATIONS (Continued)	FROM	TO
<u>Red Clay</u>	<u>0</u>	<u>20</u>			
<u>Red Sanded</u>	<u>20</u>	<u>131</u>			
<u>Course Sand</u>	<u>131</u>	<u>160</u>			

IF MORE SPACE IS NEEDED, USE BACK

If well telescopes please sketch and show depths.

GROUND LEVEL

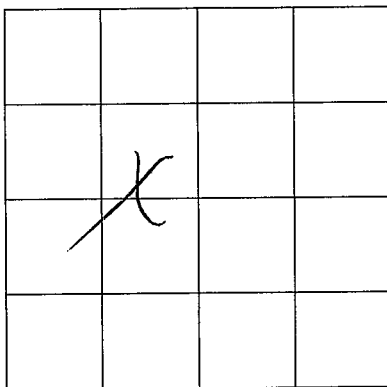

SECTION 25

Please indicate well location X.

ADDITIONAL INFORMATION

If more than one screen,
show location of each on sketch.