

**MISSISSIPPI DEPARTMENT OF ENVIRONMENTAL QUALITY**

Office of Land and Water Resources

P. O. Box 10631  
Jackson, MS 39289-0631  
**WATER WELL DRILLERS LOG**

COUNTY WELL LOCATED <i>Walthall</i>	
WELL NUMBER <i>C</i>	CODED
DATE WELL COMPLETED <i>June 22, 94</i>	

PERMIT NUMBER
NAME OF DRILLING FIRM <i>Fitzgerald Well Serv</i>

NAME & MAILING ADDRESS OF LANDOWNER <i>Earliest Holmes</i>			
<i>RR 3 Tylertown, MS.</i>			
WELL LOCATION: SEC	TOWNSHIP	RANGE	
<i>13</i>	<i>3</i>	<i>N 10 E</i>	<i>W</i>
DISTANCE	DIRECTION	NEAREST TOWN	
<i>7</i> Miles	<i>WNW</i>	<i>Tylertown</i>	
OTHER LANDMARK			
WELL PURPOSE: Home, Irrigation, Municipal, Industrial, Fish Pond, etc. <i>Home</i>			

PUMP DATA			
PUMP TYPE (Circle One): <input checked="" type="radio"/> Submersible, <input type="radio"/> Turbine, <input type="radio"/> Jet, <input type="radio"/> Flowing Well, Other (Describe) _____			
POWER TYPE (Circle One): <input checked="" type="radio"/> Electric, <input type="radio"/> Tractor, <input type="radio"/> Diesel, <input type="radio"/> Gasoline, <input type="radio"/> Butane, Other (Describe) _____ H/P <i>1/2</i>			
Pump Capacity (GPM) <i>10</i>	No. of Stages <i>8</i>	Setting Depth <i>60</i>	FT.
PUMP TEST			
Well yielded <i>15</i> GPM with a drawdown of <i>2</i> ft. after <i>2</i> hours of pumping			

WELL DATA			
Well Depth <i>64</i>	Casing Diameter (In.) <i>4</i>	Casing Length (Ft.) <i>54</i>	
Type of Casing <i>MSC</i>	Hole Depth <i>64</i>	Depth to Static Water Level <i>52</i>	

LOG DATA			
TYPE OF LOG RUN (Circle One): <input checked="" type="radio"/> Electric, <input type="radio"/> Gamma Ray, <input type="radio"/> Density, <input type="radio"/> Sonic, <input type="radio"/> Neutron, Other (Describe) _____			
Name of Organization Running Log			

TYPE OF COMPLETION: (Circle One or More):  
 Gravel Packed,  Underreamed,  Telescoped,  
 Natural Development,  Open Hole,  Other  
 (Describe) \_\_\_\_\_

GEOLOGIC DATA (Office Use Only)			
Surface Elev.	Geologic Unit	Unit Thickness	Depth to Top
Subs. SWL	Date	Qualifier Test	

WELL GROUTED TO A DEPTH OF *10* FEET  
 Type Grout (circle one): Cement, Bentonite, or  Mix

SCREEN DATA			
Diameter - Inches <i>4</i>	Length - Feet <i>10</i>	Slot Size - Inches <i>1012</i>	
Screen Type <i>MC</i>	Depth to Bottom - Feet <i>64</i>		

Driller's Remarks *Dept. of Environmental Quality Office of Land & Water Resources*

Top of Lap Pipe or Reduction in Casing


FEET  IF TELESCOPED OR MORE THAN ONE SCREEN: USE BACK PAGE

DESCRIPTION OF FORMATIONS ENCOUNTERED	FROM		TO		FORMATIONS (Continued)	FROM	TO
<i>Red Clay</i>	<i>0</i>	<i>20</i>					
<i>Red Sand</i>	<i>20</i>	<i>45</i>					
<i>Coarse Sand Gravel</i>	<i>45</i>	<i>64</i>					

IF MORE SPACE IS NEEDED, USE BACK

If well telescopes please sketch and show depths.

GROUND LEVEL

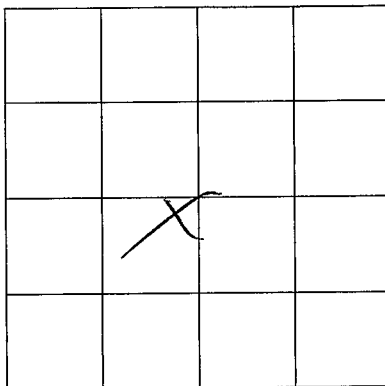

SECTION 13

Please indicate well location X.

ADDITIONAL INFORMATION

If more than one screen,  
show location of each on sketch.