

MISSISSIPPI DEPARTMENT OF ENVIRONMENTAL QUALITY

Office of Land and Water Resources

P. O. Box 10631
Jackson, MS 39289-0631
WATER WELL DRILLERS LOG

COUNTY WELL LOCATED
WAT thall

WELL NUMBER C CODED

DATE WELL COMPLETED
APR 10/95

PERMIT NUMBER

NAME OF DRILLING FIRM
F. F. FITZGERALD Well Serv

NAME & MAILING ADDRESS OF LANDOWNER
Roger Perez
R.R. Lytle town ms.

WELL LOCATION: SEC 15 TOWNSHIP 3 RANGE 10 E W

DISTANCE 1/4 Miles DIRECTION N NEAREST TOWN DINAH

OTHER LANDMARK

WELL PURPOSE Home Irrigation, Municipal, Industrial, Fish Pond, etc.
Home

PUMP DATA

PUMP TYPE (Circle One):
 Submersible, Turbine, Jet, Flowing Well,
Other (Describe)

POWER TYPE (Circle One):
 Electric, Tractor, Diesel, Gasoline, Butane,
Other (Describe) H/P

Pump Capacity (GPM) 10 No. of Stages 8 Setting Depth 80 FT.

PUMP TEST

Well yielded 25 GPM with
a drawdown of 2 ft.
after 2 hours of pumping

WELL DATA

Well Depth 98 Casing Diameter (In.) 4 Casing Length (Ft.) 88

Type of Casing PVC Hole Depth 98 Depth to Static Water Level 44

TYPE OF COMPLETION: (Circle One or More):
 Gravel Packed, Underreamed, Telescoped,
 Natural Development, Open Hole, Other
(Describe)

LOG DATA

TYPE OF LOG RUN (Circle One):
 No Log Run,
Electric, Gamma Ray, Density, Sonic, Neutron,
Other (Describe)

Name of Organization Running Log

WELL GROUTED TO A DEPTH OF 10 FEET
Type Grout (circle one): Cement, Bentonite, or Mix

GEOLOGIC DATA (Office Use Only)

Surface Elev.	Geologic Unit	Unit Thickness	Depth to Top
Subs. SWL	Date	Analysis	Aquifer Test

SCREEN DATA

Diameter - Inches 4 Length - Feet 10 Slot Size - Inches .012

Screen Type PVC Depth to Bottom - Feet 98


Driller's Remarks

DESCRIPTION OF FORMATIONS ENCOUNTERED	FROM	TO	FORMATIONS (Continued)	FROM	TO
<u>Red clay</u>	<u>0</u>	<u>20</u>	RECEIVED JUN 14 1995 Dept. of Environmental Quality Office of Land & Water Resources		
<u>Red Sand</u>	<u>20</u>	<u>65</u>			
<u>Coarse Sand & gravel</u>	<u>65</u>	<u>98</u>			

IF MORE SPACE IS NEEDED, USE BACK

If well telescopes please sketch and show depths.

GROUND LEVEL

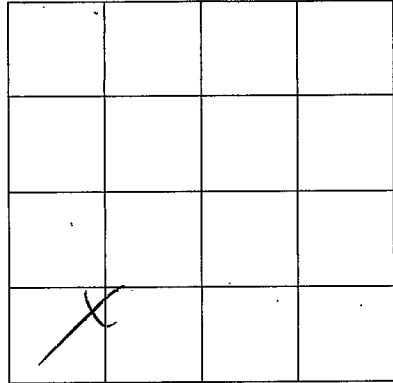

SECTION 15

Please indicate well location X.

ADDITIONAL INFORMATION

If more than one screen,
show location of each on sketch.